


TOWN OF LEXINGTON — BOARD OF PUBLIC WORKS

WATER DIVISION

Sketch of Service Here

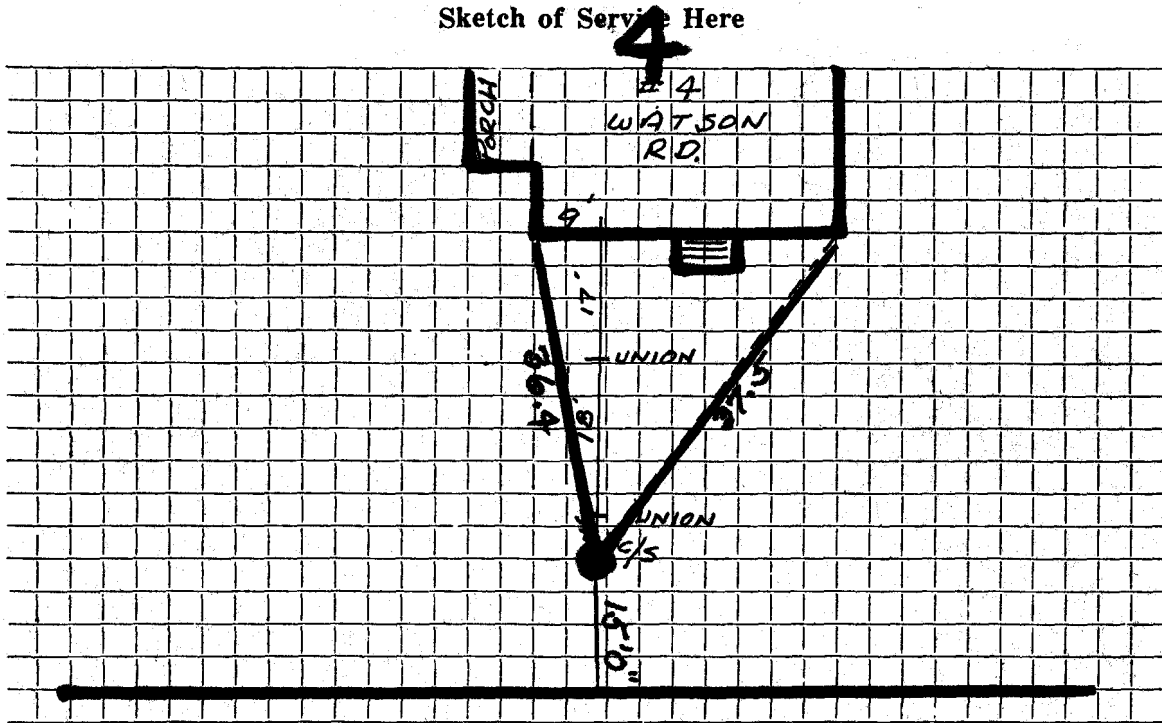

Connection made in WATSON RD. Street. Work completed

Remarks: MC KEE CONTR.