

WATER SERVICE RECORD

Name Wesley Nelson

1406

Service No. 78

Address 8 Watson Road

Location Lexington, Mass.

~~Repair-Renewal~~ New Service Eagle #1258

MAY 27 1969


Date		Material	Amount	Total	Date		Amount
12-4-68	39'	3/4" Copper Tubing			11-21-68	<i>Deposit</i>	46 18
						No Charge	
					8-17-50	Labor	2 60
					19' - 3/4"	Copper Tubing @.275	5 23
					1 - 3/4"C	Corp-cock	3 15
					1 - 3/4"C x 3/4"C	Curb-cock	3 85
					1 - Box & Rod		3 35
					Littlefield Shovel	4 hrs. @ 7.00	28 00
							46 18

DATE _____

TOWN OF LEXINGTON — BOARD OF PUBLIC WORKS

WATER DIVISION

Sketch of Service Here

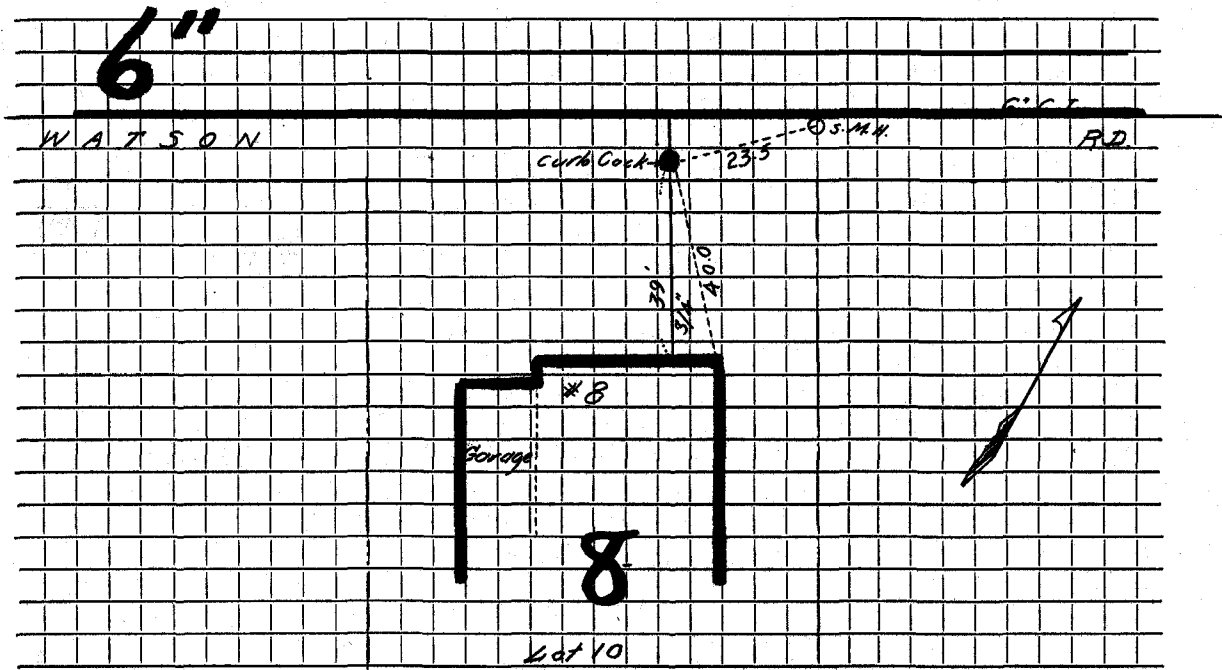

Connection made in Street. Work completed

Remarks:
.....
.....