


DATE _____

TOWN OF LEXINGTON — BOARD OF PUBLIC WORKS
WATER DIVISION

Sketch of Service Here

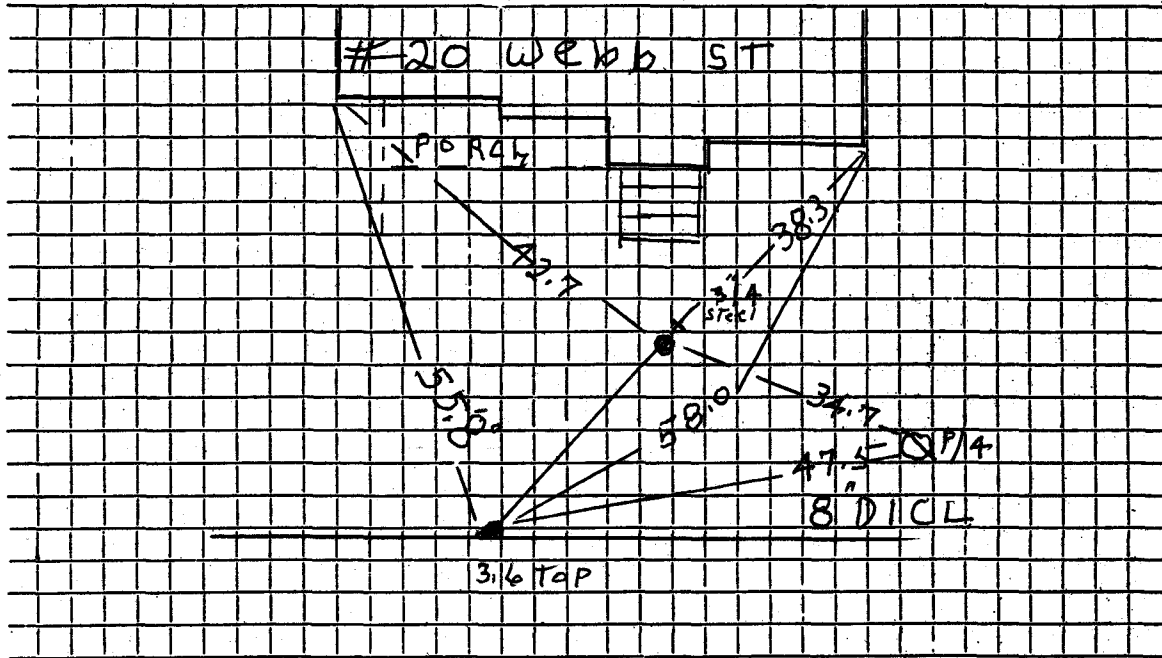

Connection made in Street. Work completed 9/5/07 DeFlie

Remarks: 3/4" Steel Pipe house To curb.