

WATER SERVICE RECORD

Name David Zaloga

Service No. ¹⁷⁵
64

Address 24 Webb Street

Location

Repair—Renewal—New Service WO #3878 DeFelice


FEB 13 1978

Date	Material	Amount	Total	Date	Amount	
12/3/75	labor	11. 02		12-9-75	Deposit	100.00
	10%OH	1. 10	12. 12			
	6' 3/4" Copper Tubing @ .67		4. 02			
	1 3/4" Curb Stop		13. 70			
	1 3/4" Corporation		10. 53			
	1 hr. truck		3. 00			
	1 box and rod		15. 40			
			58. 77			
			41.23			
			100.00			
2/17/76	48' 3/4" Copper tubing					

DATE _____

TOWN OF LEXINGTON — BOARD OF PUBLIC WORKS
WATER DIVISION

Sketch of Service Here

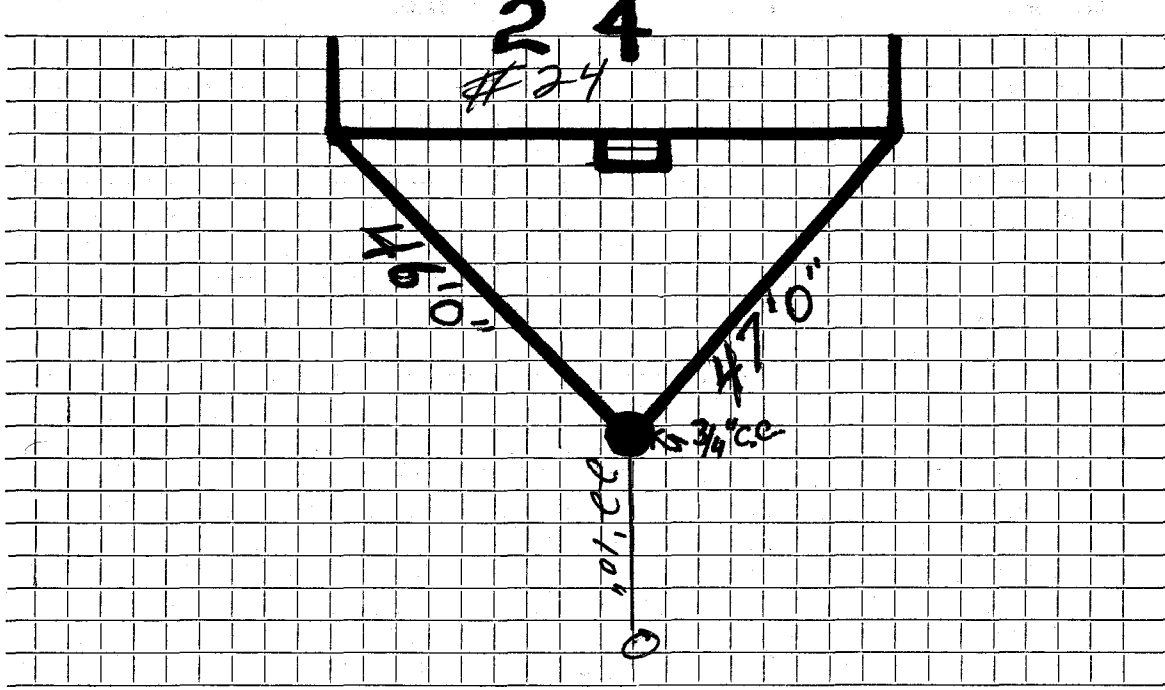

Connection made in Street. Work completed

Remarks:
.....
.....