

WATER SERVICE RECORD

4387

Name Ralph Frissore

Service No. 15

Address 29-27 Webb Street

Location

~~REPAIR WORK~~ New Service


Comm. 4-4-60

Date	Material	Amount	Total	Date	Amount
3-24-60	Labor	3.46		3-24-60	30.00
	10% O.H.	.35	3.81		
	45' 3/4" Copper tubing@ .42		18.90		
	1 3/4" Cx 1/2 IWH Stop & Waste		5.88		
	1 Hr. Trucking@ .75		.75		
			29.34		
				NON CHARGE	
				Labor	
				1 1/2 Straight tailpiece	.50
				1 1/2 Offset tailpiece	.50
					1.00
				* Applied to W.H.C. #16	

TOWN OF LEXINGTON — BOARD OF PUBLIC WORKS

WATER DIVISION

Sketch of Service Here

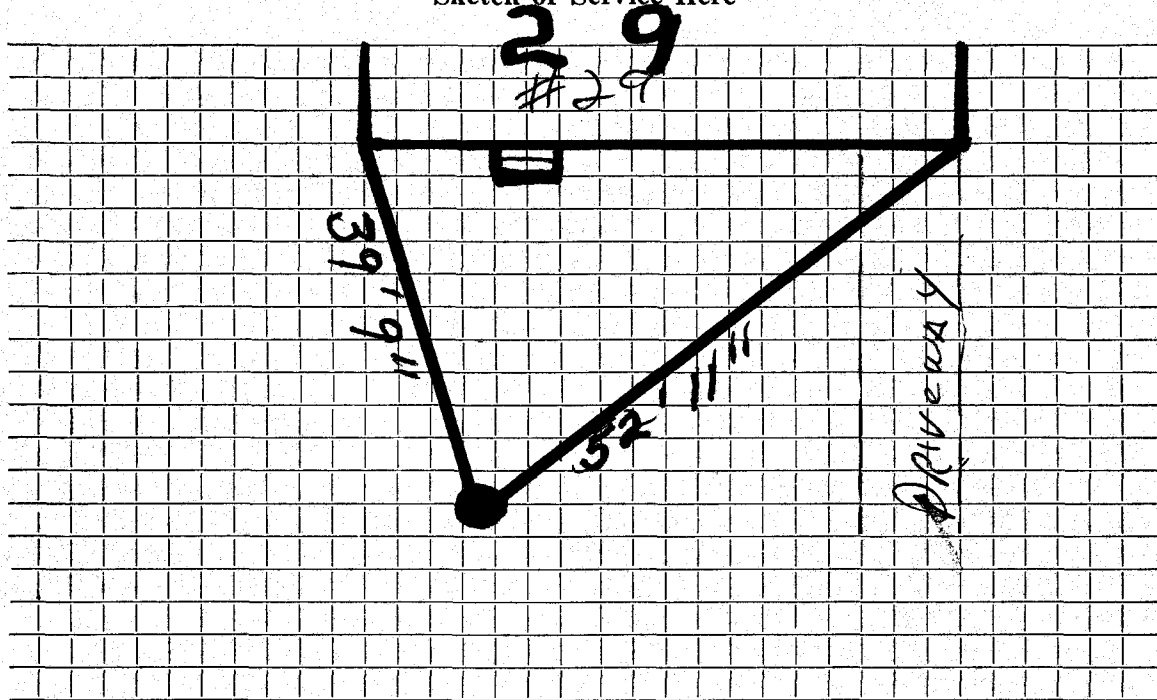

Connection made in Street. Work completed

Remarks:
.....
.....