

WATER SERVICE RECORD

Name **Scott Properties**

Service No. **38**

Address **34 Webb Street**

Location **Lot 81**

~~Repair~~ ~~Renewal~~ **New Service** DeFlice permit # **2110**


AUG 14 1972

Date		Material	Amount	Total	Date		Amount
					7-10-72	Deposit	36.38
						<u>NON CHARGE</u>	
					8-31-59	Labor	12 48
						12' 3/4" Copper tubing @.38	4 56
						1 3/4" C Corp Cock	4 67
						1 3/4" C Curb Cock	6 07
						1 Box & Rod	5 00
						1/2 Hr. Town Shovel	3 25
						1 Hr. Trucking	75
7/11/72	60'	3/4" Copper					36 78

TOWN OF LEXINGTON — BOARD OF PUBLIC WORKS

WATER DIVISION

Sketch of Service Here

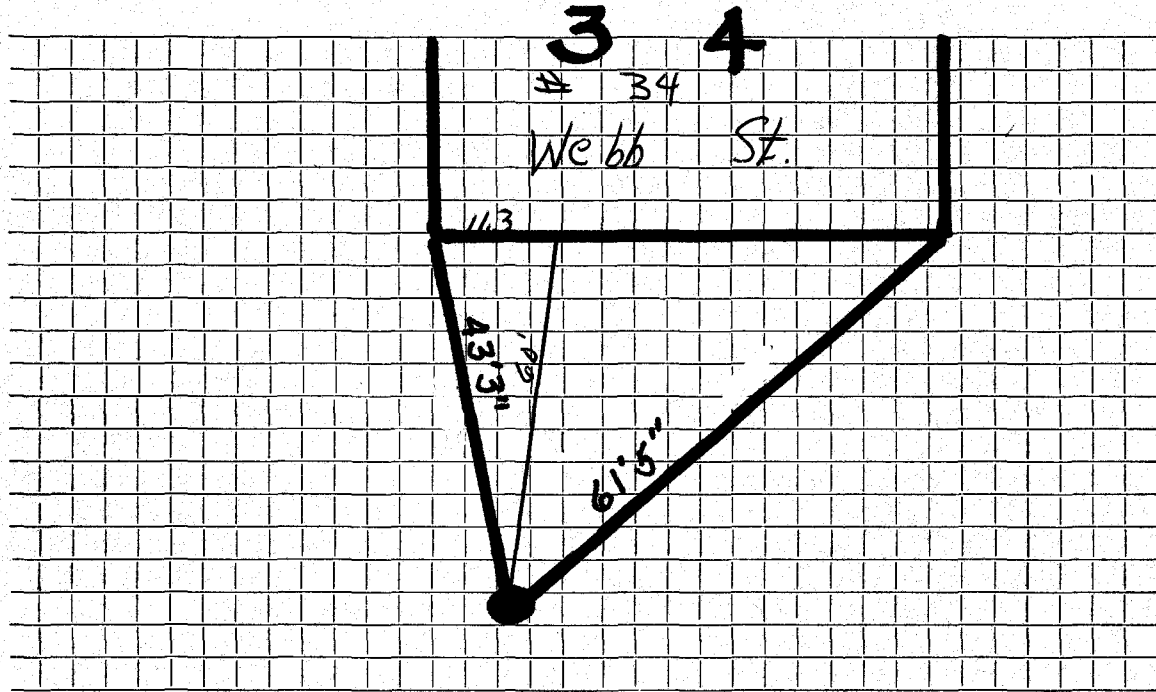

Connection made in Street. Work completed

Remarks:
.....
.....