

WATER SERVICE RECORD

Name Scott Properties

Service No. 39

Address 36 Webb Street

Location Lot 83

~~Repair - Renewal~~ - New Service

DeFlice Bros. permit # 2111


AUG 14 1972

Date		Material	Amount	Total	Date		Amount
					7-10-72	Deposit	33 94
						<u>NON CHARGE</u>	
					8-31-59	Labor	10 40
						10' 3/4" Copper tubing @.38	3 80
						1 3/4" C Corp Cock	4 67
						1 3/4" C Curb Cock	6 07
						1 Box & Rod	5 00
						1/2 Hr. Town Shovel	3 25
						1 Hr. Trucking	75
7/11/72	60'	3/4" Copper					33 94

TOWN OF LEXINGTON — BOARD OF PUBLIC WORKS

WATER DIVISION

Sketch of Service Here

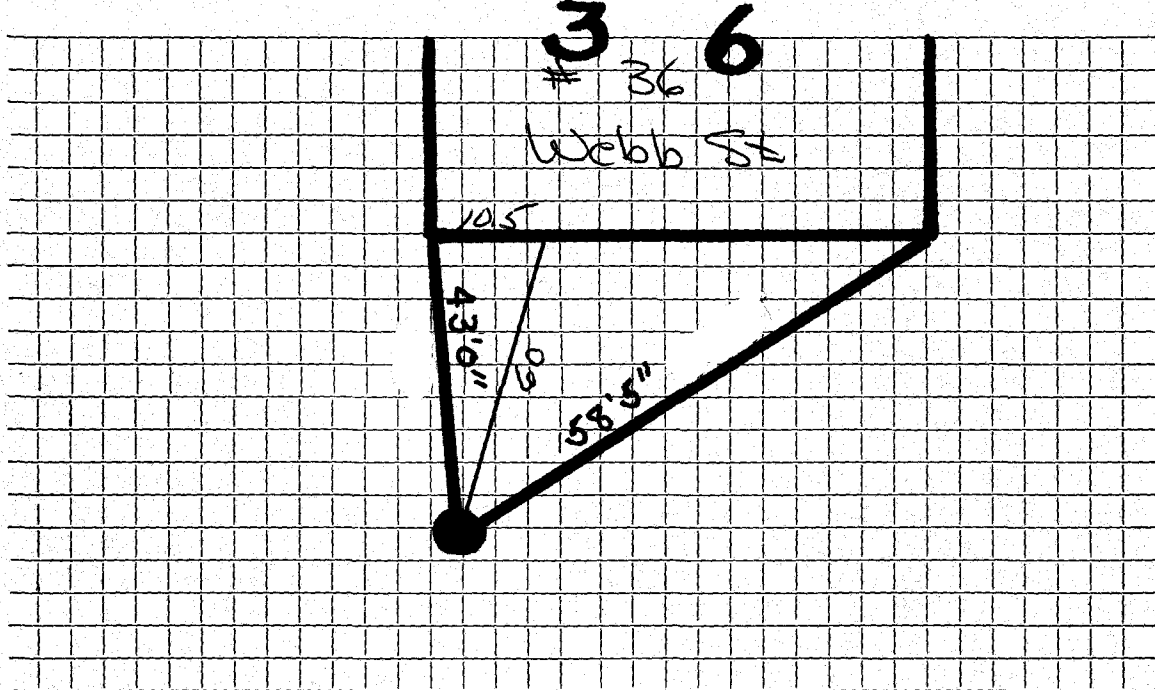

Connection made in Street. Work completed

Remarks:
.....
.....