


WATER SERVICE RECORD

Name Scott PropertiesService No. 40Address 38 Webb StreetLocation Lot 85~~Repair Work~~ New Service DeFluce Bros. permit # 2112**AUG 14 1972**

Date	Material	Amount	Total	Date		Amount
				7-10-72	<i>Deposit</i>	<i>36 78</i>
					NEW SERVICE	
				8-31-59	Labor	12 48
				12'	3/4" Copper tubing @.38	4 56
				1	3/4" C Corp Cock	4 67
				1	3/4" C Curb Cock	6 07
				1	Box & Rod	5 00
				1/2	Hr. Town Shovel	3 25
7/13/72	60' 3/4" Copper			1	Hr. Trucking	" 75
						36 78

TOWN OF LEXINGTON — BOARD OF PUBLIC WORKS
WATER DIVISION

Sketch of Service Here

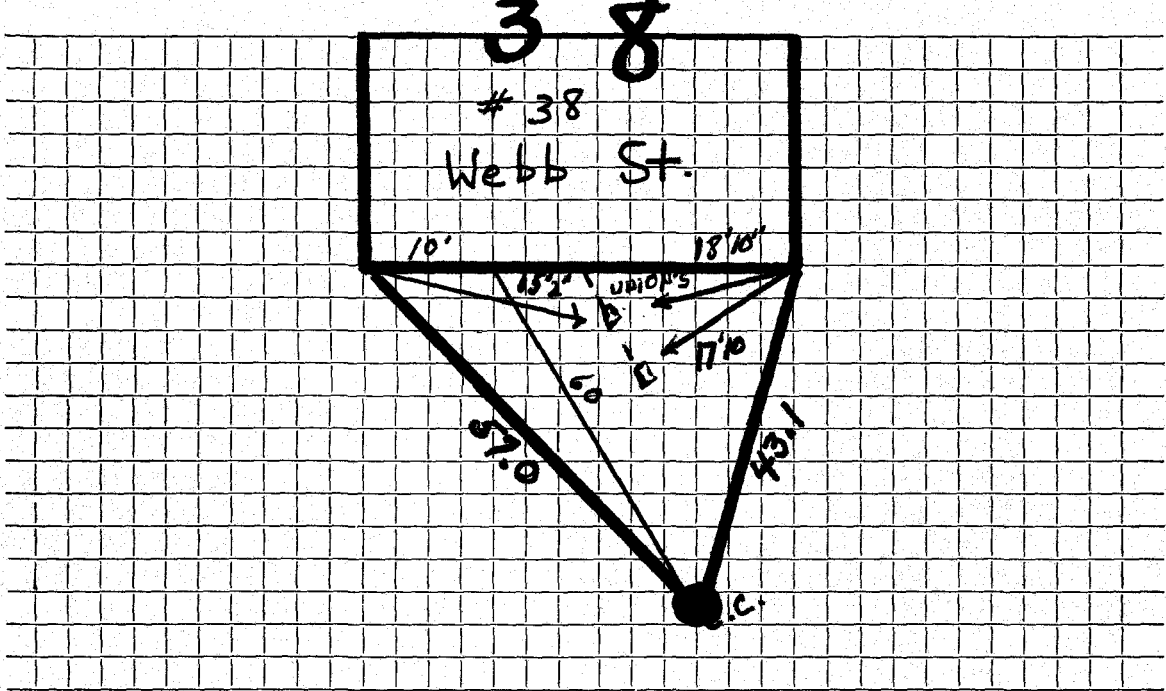

Connection made in Street. Work completed

Remarks:
.....
.....