

WATER SERVICE RECORD

6112

Name Scott Properties

Service No. 41

Address 40 Webb Street

Location

~~Repair Renewal~~ New Service W.O. # 9883



FEB 12 1973

Date		Material	Amount		Total	Date	Amount
8/3/72		Labor	73	12		7/10/72	Deposit 100.00
8/25		"	31	73		5/18/73	Balance 90.46
		10% O.H.	10	49	115		190.46
12'		3/4" Copper pipe @ .79			9		
	1	3/4" Curb cock			11		
	1	3/4" Corporation			9		
	1	Box & Rod			7		
	1/2	Ton hot top @ 8.00			4		
	3 1/2	Hrs. Trucking 3.00			10		
	1/2	" " 1.50			75		
	2	Hrs. Shovel 6.50			13		
	1	Hr. Compressor			5		
	1	Hr. Roller			2		
		Trailer			2		
					190		
					46		
		60' 3/4" copper					

TOWN OF LEXINGTON — BOARD OF PUBLIC WORKS
WATER DIVISION

DATE _____
JWH/1/14/97
- bottom?

Sketch of Service Here

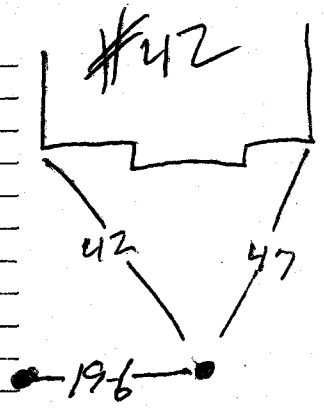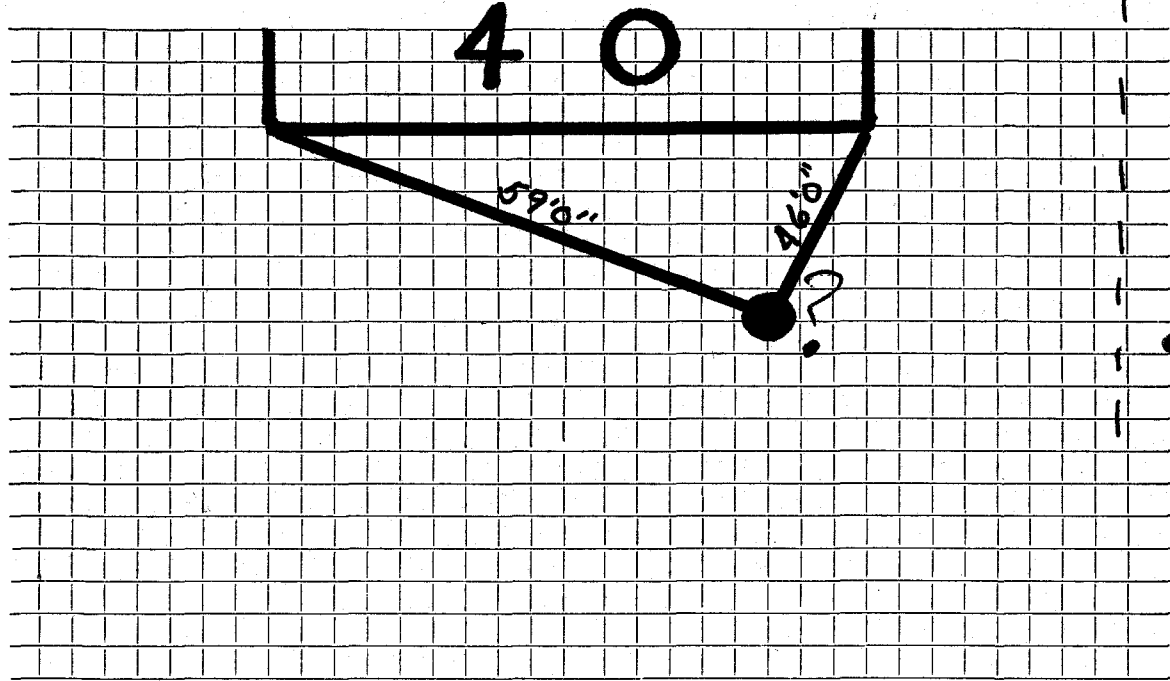

Connection made in Street. Work completed.....

Remarks: *curb for #40 is in the yard for #42*