

**WATER SERVICE RECORD**

Name

Service No.

Address **42 WEBB ST**

Location

Repair—Renewal—New Service


Date		Material	Amount		Total		Date	Amount	
7-15-72	60	↓? 3/4 copper					9-1-59		
							15'	3/4 Copper	
							1	3/4 Corp	
							1	3/4 curb	
							1	box steel rod	

DATE 8-14-00

TOWN OF LEXINGTON — BOARD OF PUBLIC WORKS

WATER DIVISION

Sketch of Service Here

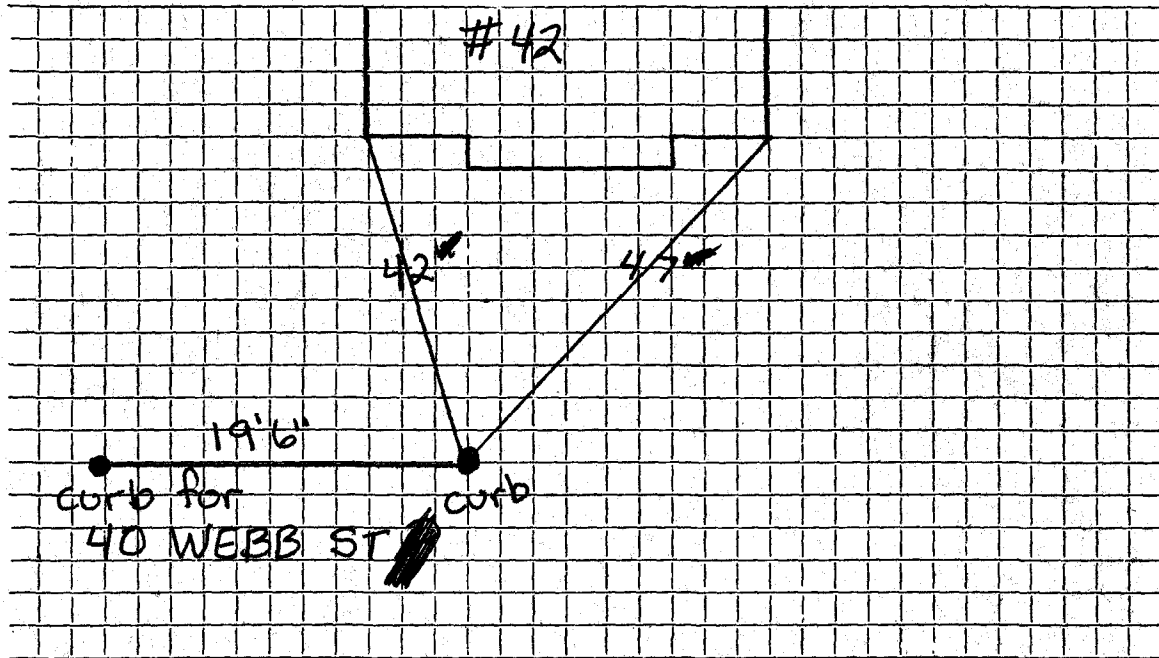

Connection made in ..... Street. Work completed .....

Remarks: *Old tie wrong* .....