

## WATER SERVICE RECORD

Name Tricorn Homes

Service No. 92

Address 52 Webb Street

Location Lot 90


~~Repair Renewal~~ - New Service Russell Sibley Permit #72

Comm 9-21-64

Date		Material	Amount	Total	Date		Amount
9-1-64	51'	3/4" Copper tubing			8-18-64	Deposit	41 04
						<u>NON CHARGE</u>	
					9-1-59	Labor	15 60
						15' 3/4" Copper tubing @.38	5 70
						1 3/4" C Corp Cock	4 67
						1 3/4" C Curb Cock	6 07
						1 Box & Rod	5 00
						1/2 Hr. Town Shovel	3 25
						1 Hr. Trucking	75
							41 04

TOWN OF LEXINGTON — BOARD OF PUBLIC WORKS  
WATER DIVISION

Sketch of Service Here

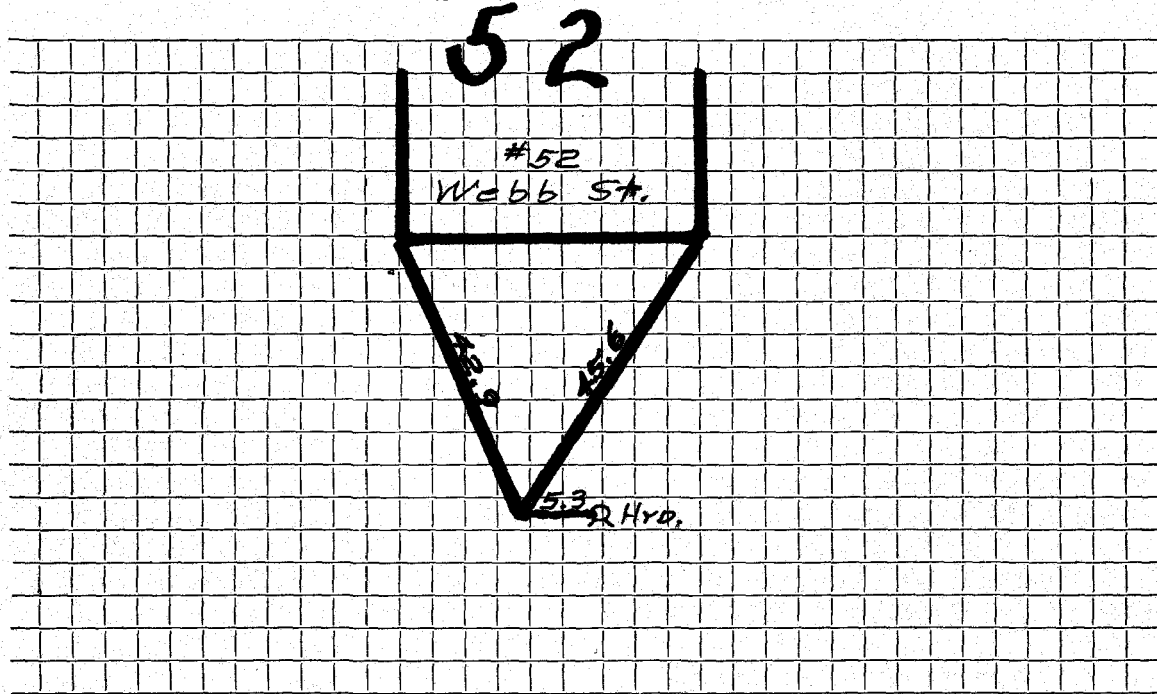

Connection made in ..... Street. Work completed .....

Remarks: .....  
.....  
.....