

WATER SERVICE RECORD

Name Raymond DeSimone

Service No. 278

Address 53 Webb Street

3313

Location

~~Repair - Renewal~~ - New Service


Comm. 12-3-56

Date	Material	Amount	Total	Date	Amount
9/13/56	Labor	3 80		9-7-56	Deposit \$ 20 00
	10% Overhead	38	4 18	12-3-56	Refund 10 11
	1 - 3/4" C x 1/2 I.W.H. stop & waste		4 96		<u>NON CHARGE</u> 9 89
	1 hr. trucking @ .75		75		Labor 20 47
			9 89		
				37' - 3/4" Copper tubing @ .4850	17 95
				1 - 3/4" C. corp-cock	4 64
				1 - 3/4" C. curb-cock	5 94
				1 box and rod	4 62
				1 1/2 straight tail piece	50
				1 1/2 offset tail piece	50
				4 2/3 hrs. Littlefield shovel @ 8.50	39 66
					94 28

DATE _____

TOWN OF LEXINGTON — BOARD OF PUBLIC WORKS
WATER DIVISION

Sketch of Service Here

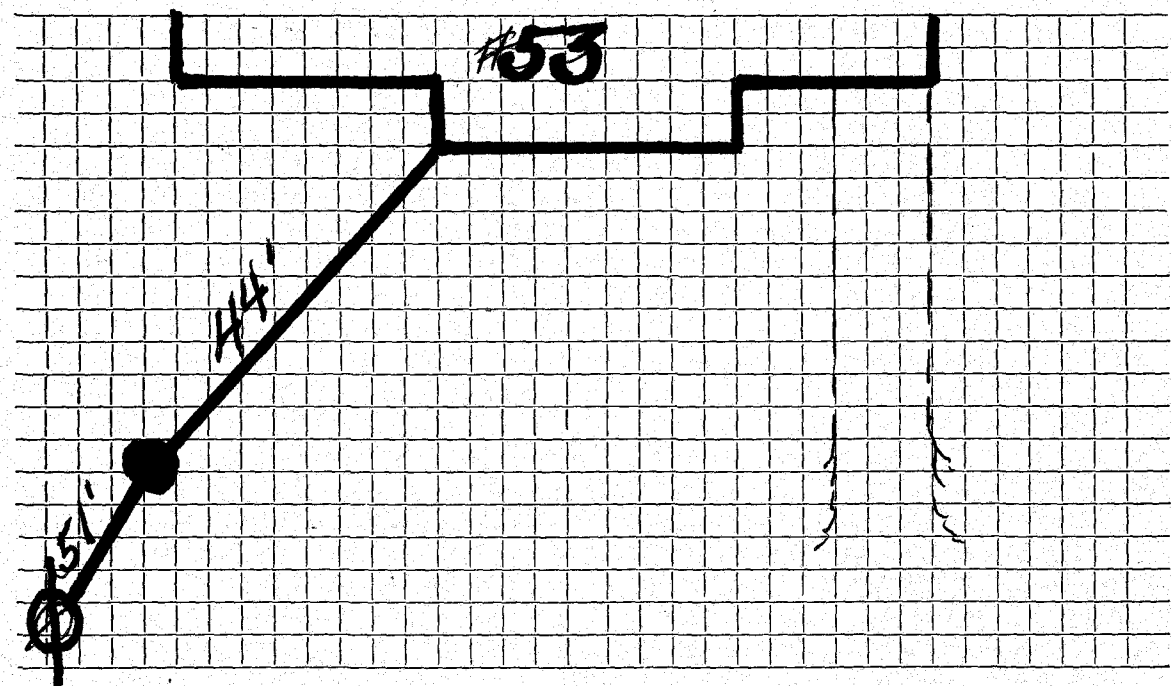

Connection made in Street. Work completed

Remarks:
.....
.....