

WATER SERVICE RECORD

Name *Raymond E. DeSimone*

Service No.

Address *59 Webb Street*

Location

Repair—Renewal—New Service *Valeri #4696*

Date	Material	Amount	Total	Date	Amount
<i>8-26-88</i>	<i>56' 3/4" Copper</i>				
				8/26/88	56' 3/4" Copper

IN
OUTSIDE


~~8/26/88 56' 3/4" Copper~~

DATE _____

TOWN OF LEXINGTON — BOARD OF PUBLIC WORKS

WATER DIVISION

Sketch of Service Here

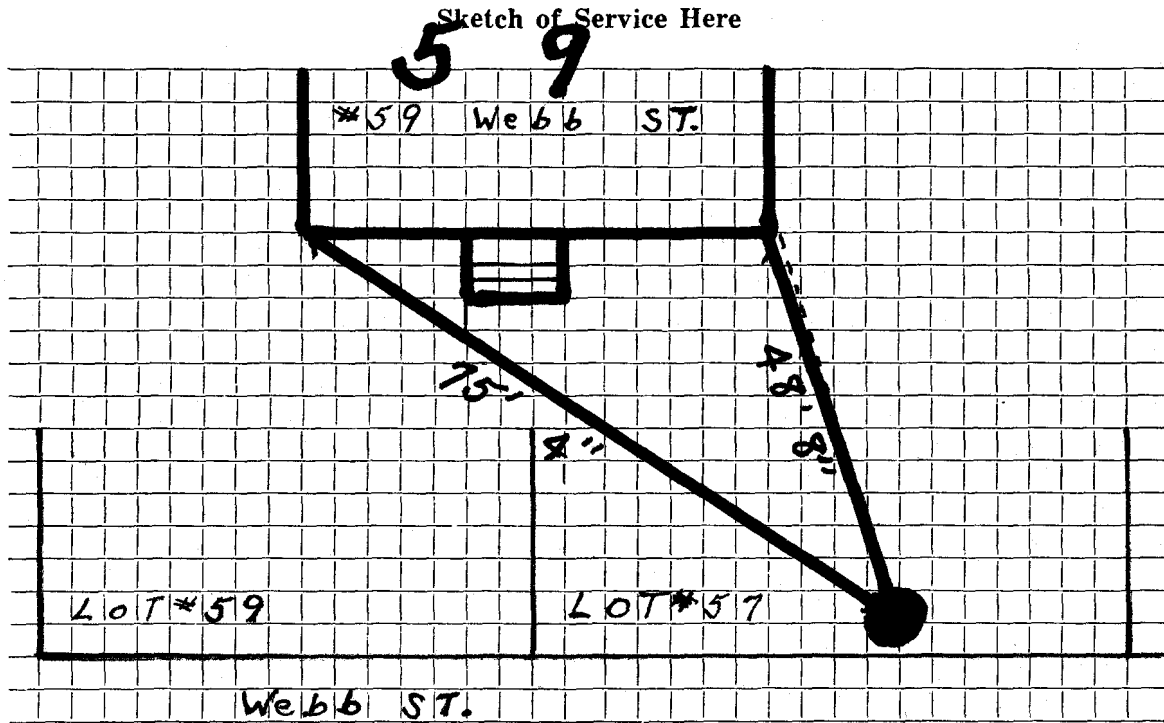

Connection made in Street. Work completed

Remarks:

.....

.....