

WATER SERVICE RECORD

Name Bernard Maloney

Service No. 46

Address 61 Webb Street

Location Lot 121


~~Repair & Renewal~~ - New Service WO # 7217

Comm 7-16-62

Date	Material	Amount	Total	Date	Amount	
5/15/62	Labor	22 13		5-19-62	Deposit	100 00
	10% O.H.	2 21	24 34	7-16-62	Returned	33 36
46'	3/4" Copper Tubing @ .42		19 32			66 64
1	3/4" Cx 1/2 IWH Stop & Waste		6 17		<u>NON CHARGE</u>	
1	3/4" C 3 Part Union		2 41	8-31-59	Labor	29 12
1	Bow & Rod		4 90		28' 3/4" Copper tubing	10 64
1	Hr. Town Shovel @ 6.50		6.50		1 3/4" C Corp Cock @.38	4 67
1	Hr. Trucking @ 3.00		3 00		1 3/4" C Curb Cock	6 07
			66 64		1 Box & Rod	5 00
					1/2 Hr. Town Shovel	3 25
					1 Hr. Trucking	75
						59 50
				5/15/62	1 1/2 Straight Tailpiece	50
					1 1/2 Offset Tailpiece	50
						60 50

TOWN OF LEXINGTON — BOARD OF PUBLIC WORKS
WATER DIVISION

Sketch of Service Here

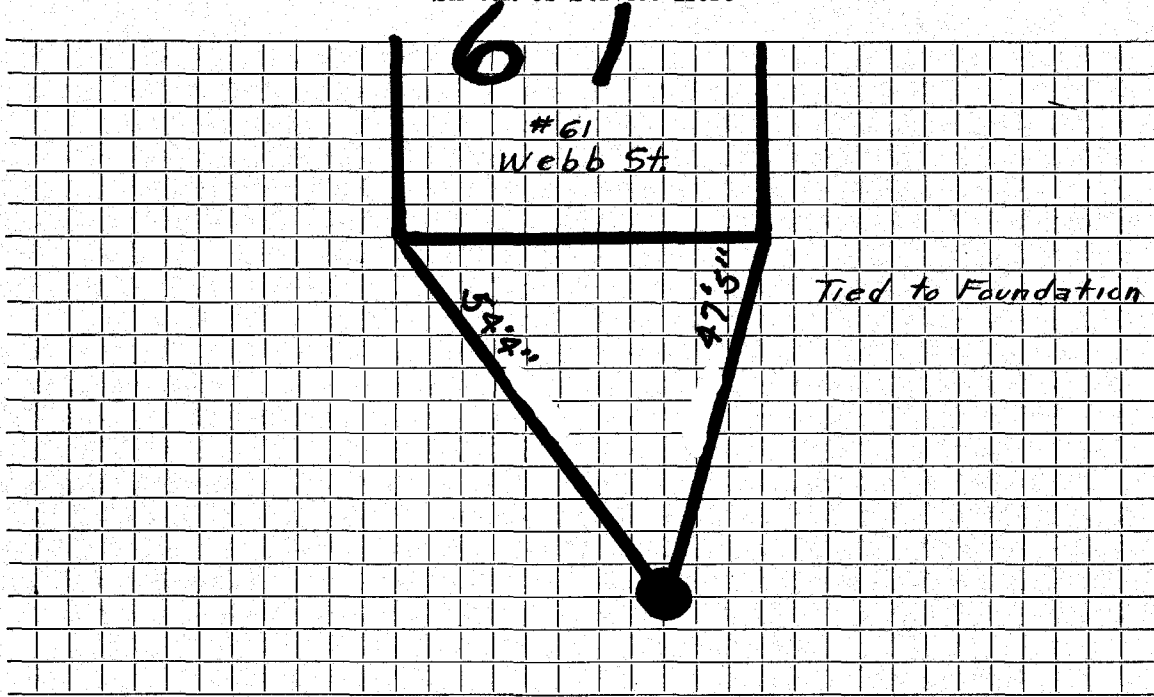

Connection made in Street. Work completed

Remarks:
.....
.....