

WATER SERVICE RECORD

#872

Name Leslie J. Wood

Service No. 3

Address 62 Webb Street

Location

Repair-Renewal-New Service


Comm. 6-2-58

Date	Material	Amount	Total	Date	Amount
1/31/58	Labor	2 04		1-7-58	Deposit \$ 15.00
	10% overhead	20	2 24	6-2-58	Refund 3.26
1 -	3/4" Cx 1/2 I.W.H. Stop & Waste	4 96			\$ 11.74
2 -	3/4" C. Unions (3 part) @ 2.27-	4 54			NON CHARGE
			11 74	1/31/58	Labor 26 32
				25' -	3/4" Copper tubing @ .37 9 25
				1 -	3/4" C. Corp Cock 4 64
				1 -	3/4" C. Curb Cock 5 94
				1	Box & Rod 4 62
				1 -	1/2 Straight tailpiece 50
				1 -	1/2 Offset tailpiece 50
				2 hrs.	Town Shovel @ 6.50 13 00
				2 hrs.	Trucking @ .75 1 50
					<u>66 27</u>

DATE \_\_\_\_\_

TOWN OF LEXINGTON — BOARD OF PUBLIC WORKS  
WATER DIVISION

Sketch of Service Here

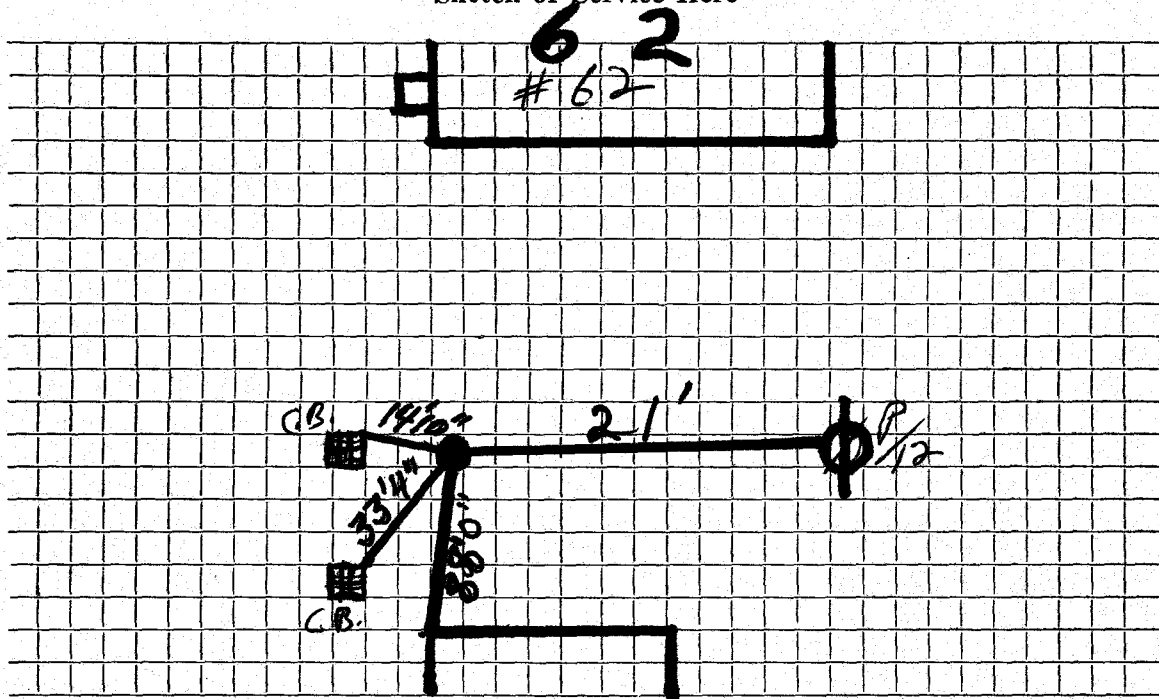

Connection made in ..... Street. Work completed .....

Remarks: .....

.....

.....