

WATER SERVICE RECORD

Name Bernard Maloney

Service No. 47

Address 63 Webb Street

Location Lot 118


~~Repair~~ New Service WO# 7218

Comm 7-16-62

Date	Material	Amount	Total	Date	Amount	
5/15/62	Labor	22 13		5-9-62	Deposit	100 00
	10% O.H.	2 21	24 34	7-16-62	Refund	34 48
	55' 3/4" Copper Tubing @ .42		23 10			65 52
	1 3/4" Cx 1/2 IWH Stop & Waste		6 17		<u>NON CHARGE</u>	
	1 3/4" C3 Part Union		2 41	8-31-59	Labor	29 12
	1 Hr. Town Shovel @ 6.50		6 50		28' 3/4" Copper tubing	10 64
	1 Hr. Trucking @ 3.00		3 00		1 3/4" C Corp Cock @.38	4 67
			65 52		1 3/4" C Curb Cock	6 07
					1 Box & Rod	5 00
					1/2 Hr. Town Shovel	3 25
					1 Hr. Trucking	75
						59 50
				5/15/62	1 1/2 Straight Tailpiece	50
					1 1/2 Offset Tailpiece	50
						60 50

TOWN OF LEXINGTON — BOARD OF PUBLIC WORKS  
WATER DIVISION

Sketch of Service Here

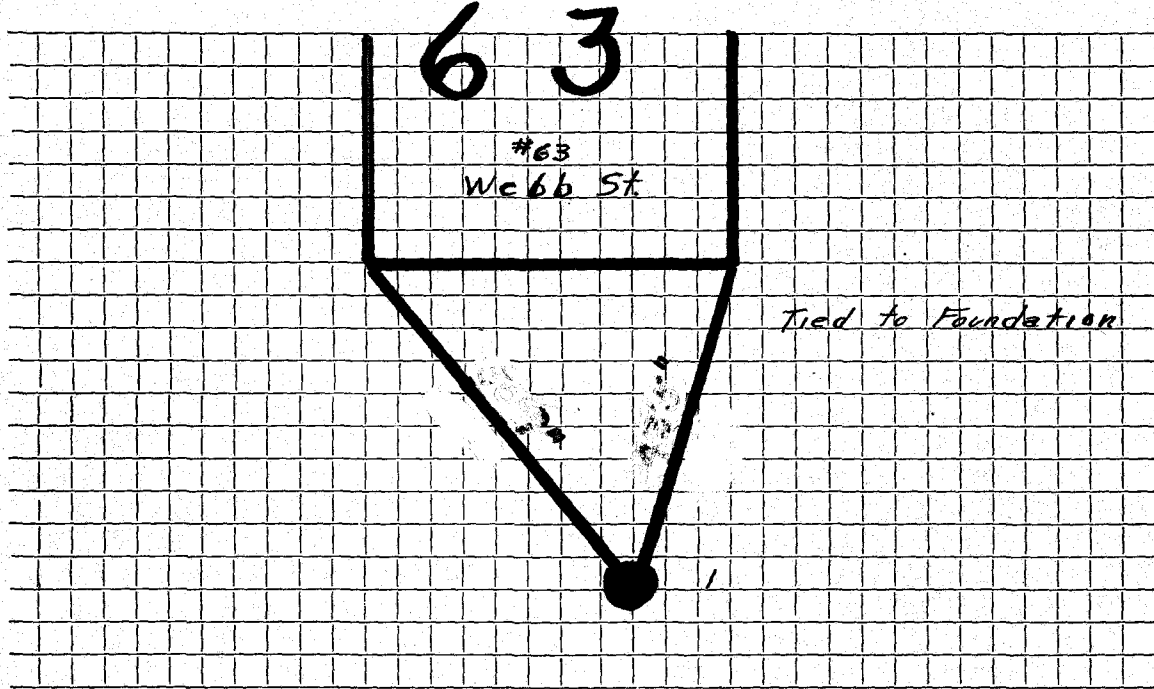

Connection made in ..... Street. Work completed .....

Remarks: .....  
.....  
.....