

WATER SERVICE RECORD

Name E & F Builders

Service No. 7

Address 64 Webb Street

Location

~~Repair~~ ~~Rebate~~ New Service 3160-WO# DeFlice #2578

AUG 16 1976


Date	Material	Amount	Total	Date	Amount	
5/19/75	labor	45.52		3-21-75	Deposit	250.00
6/26/75	labor	17.16	62.68	8-16-76	Refund	3.94
	10%OH	6.27	68.95			185.06
	18' 3/4" Copper Tubing @ 1.01		18.18			
	1 3/4" Corp.		11.58			
	1 3/4" Curb Cock		14.40			
	1 box and rod		15.40			
	1/2 ton cold patch		3.05			
	5' X 9 1/2' patch		30.00			
	2 hr. truck @ 3.00		6.00			
	2 hr. back how @ 6.50		13.00			
	1/2 hr. compressor @ 5.00		2.50			
	1/2 hr. loader @ 4.00		2.00			
			185.06			
5/29/75	38' 3/4" Copper Tubing					

DATE _____

TOWN OF LEXINGTON — BOARD OF PUBLIC WORKS

WATER DIVISION

Sketch of Service Here

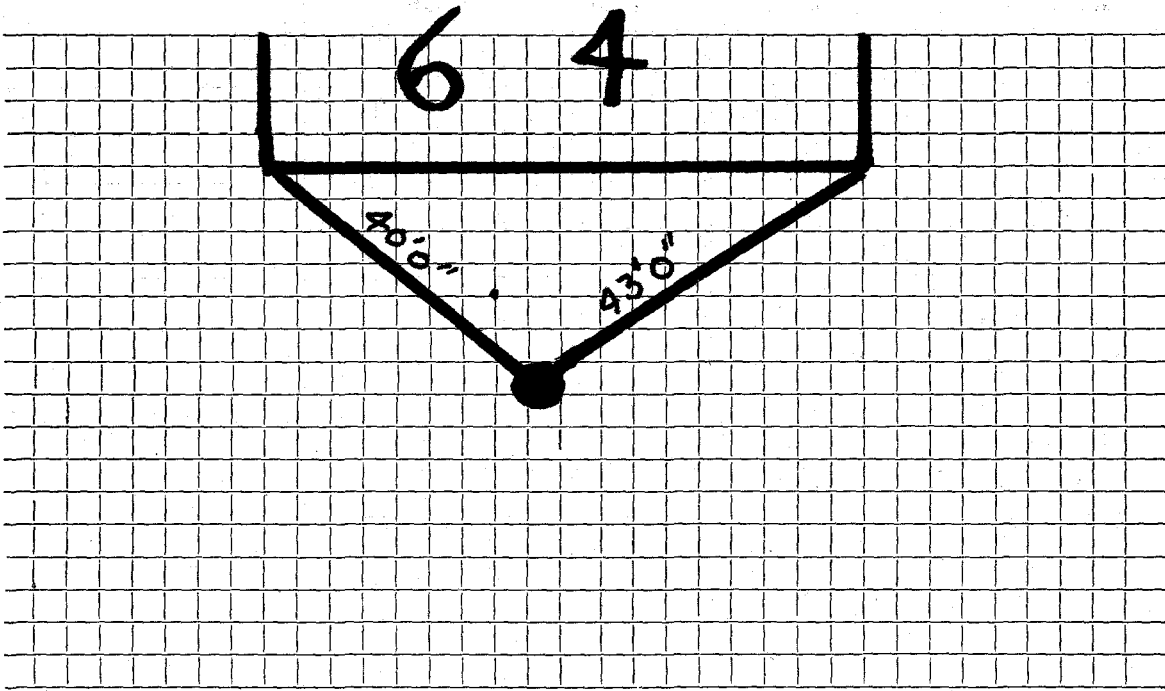

Connection made in Street. Work completed

Remarks:
.....
.....