


TOWN OF LEXINGTON — BOARD OF PUBLIC WORKS
WATER DIVISION

Sketch of Service Here

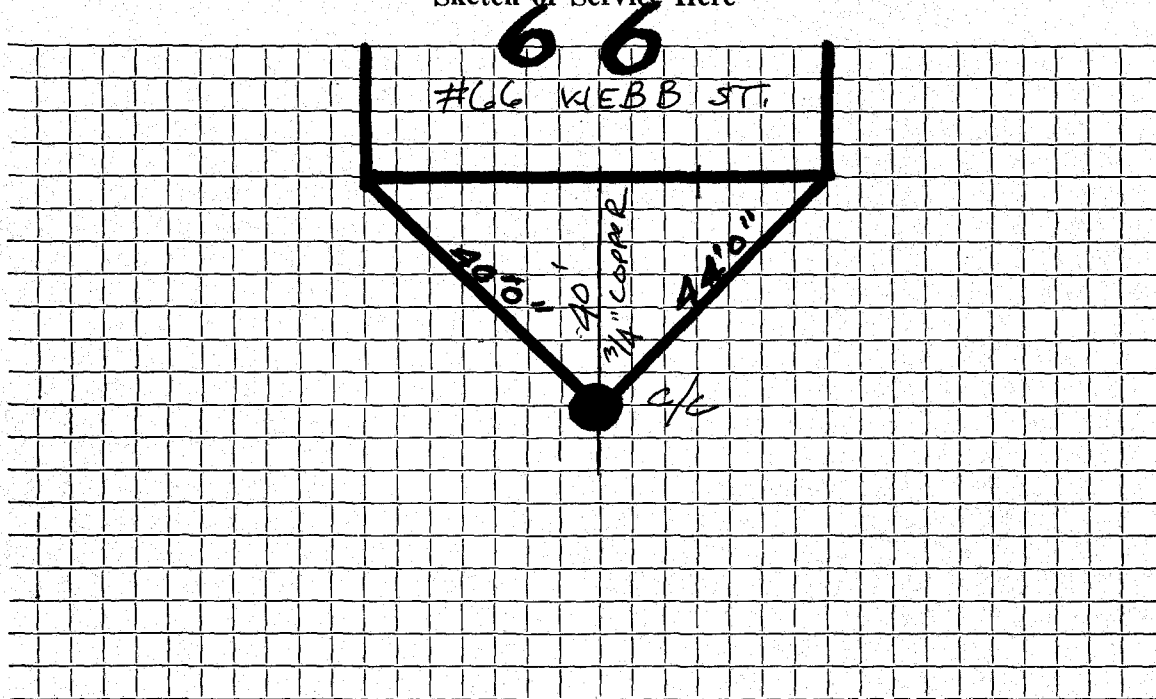

Connection made inW.E.B.B...... Street. Work completed

Remarks:
.....
.....