




DATE August 1959

TOWN OF LEXINGTON — BOARD OF PUBLIC WORKS  
WATER DIVISION

Sketch of Service Here

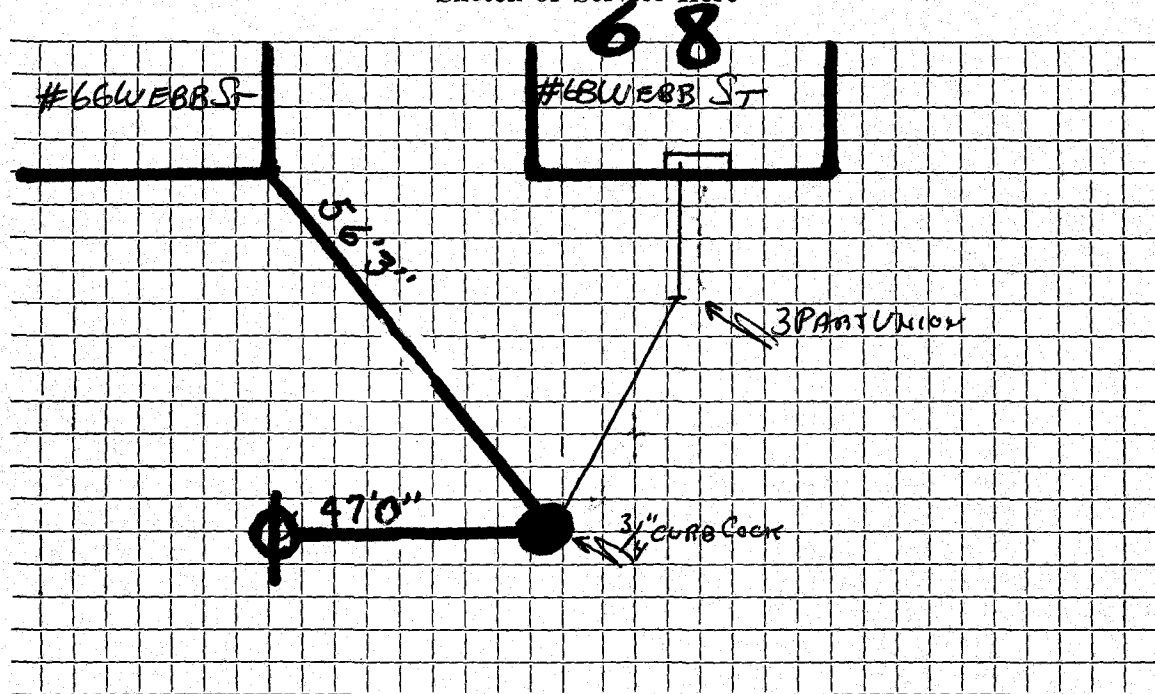

Connection made in WEBB ST Street. Work completed JAN 14, 1985

Remarks: .. Water & Sewer Are In Same Trench Approx. 4' - 3' Apart ..