


DATE MAY 1983

TOWN OF LEXINGTON — BOARD OF PUBLIC WORKS
WATER DIVISION

Sketch of Service Here

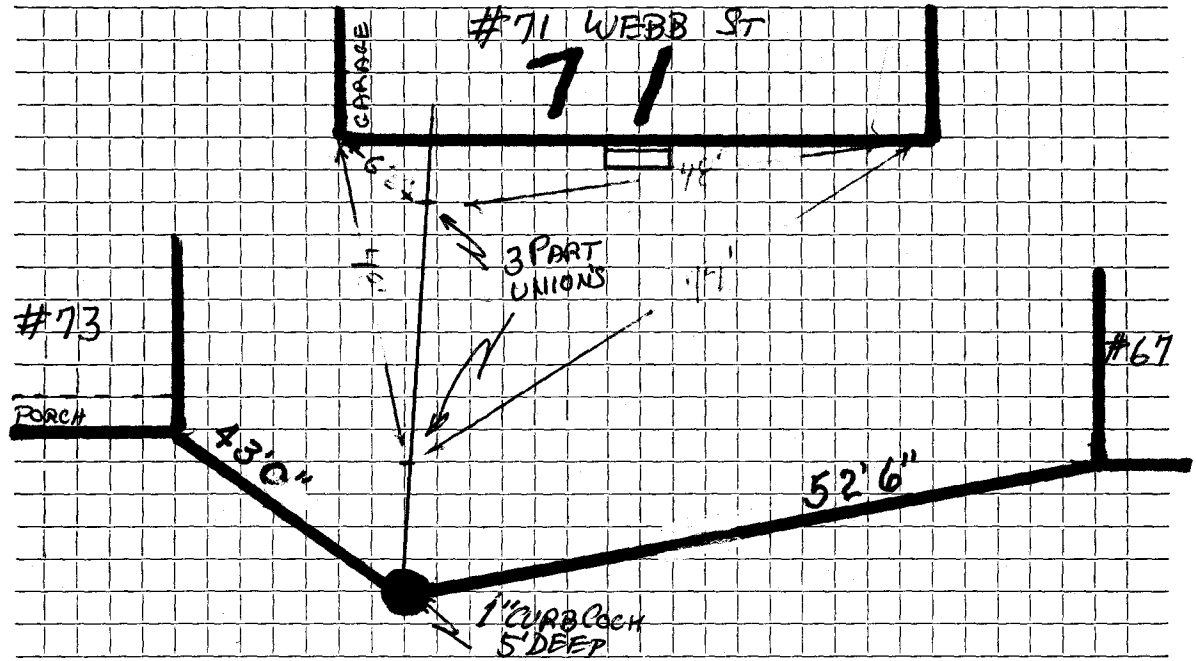

Connection made in WEBB ST Street. Work completed MAY 1983

Remarks: NO OUTSIDE INFORMATION