


DATE 3/10/2016

TOWN OF LEXINGTON — BOARD OF PUBLIC WORKS
WATER DIVISION

Sketch of Service Here

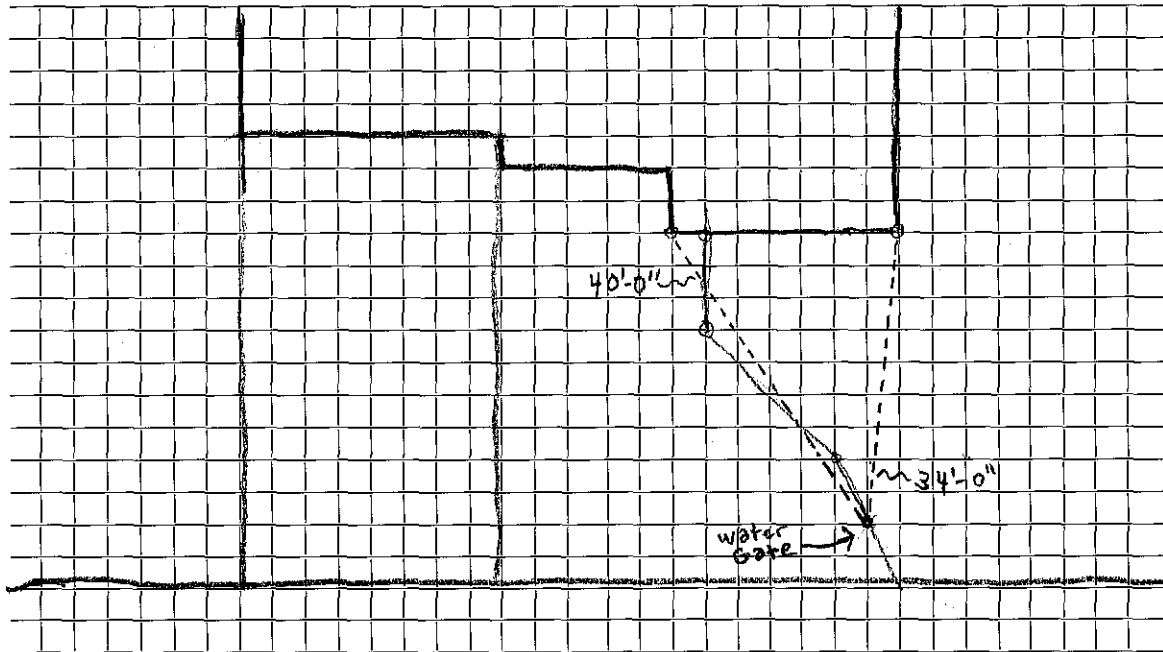

Connection made in 73 Webb Street Street. Work completed

Remarks: