

WATER SERVICE RECORD

#5576
#5816

Name Donald Doremus

Service No.

243

Address 74 Webb Street

Location

~~Repair-Renewal~~—New Service


Comm. 11-19-56

Date	Material	Amount	Total	Date	Amount
7/21/56	Labor	5 70		8-16-56	Deposit 20 00
	10% overhead	57	6 27	11-19-56	Refund 8 02
	1 - 3/4" Cx 1/2 I.W.H. Stop & Waste		4 96		NON CHARGE 11 78
	1 hr. trucking		75	7/21/56	Labor 9 90
			11 98	12' - 3/4" Copper tubing @ .4850	5 82
				1 - 3/4" C. Corp Cock	4 64
				1 - 3/4" C. Curb Cock	5 94
				1 Box & Rod	4 62
				1 - 1/2 Straight tailpiece	50
				1 - 1/2 Offset tailpiece	50
				3 hrs. Littlefield Shovel @ 8.50	25 50
					57 42

DATE _____

TOWN OF LEXINGTON — BOARD OF PUBLIC WORKS
WATER DIVISION

Sketch of Service Here

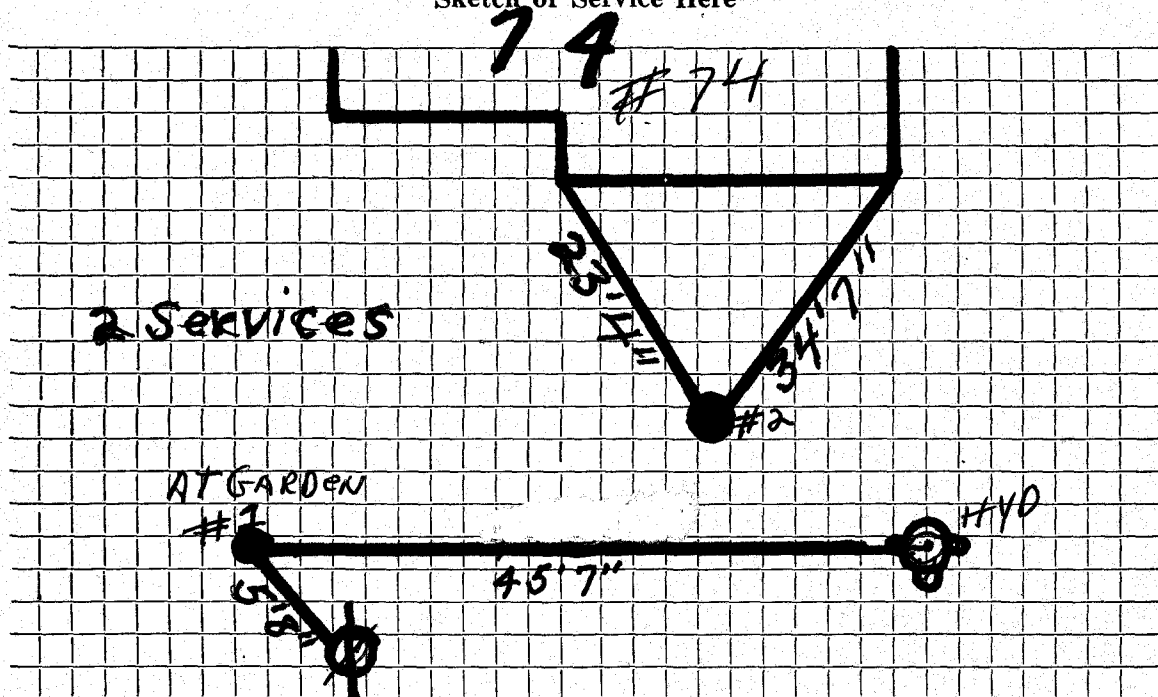

Connection made in Street. Work completed

Remarks:
.....
.....