




DATE \_\_\_\_\_

TOWN OF LEXINGTON — BOARD OF PUBLIC WORKS

WATER DIVISION

Sketch of Service Here

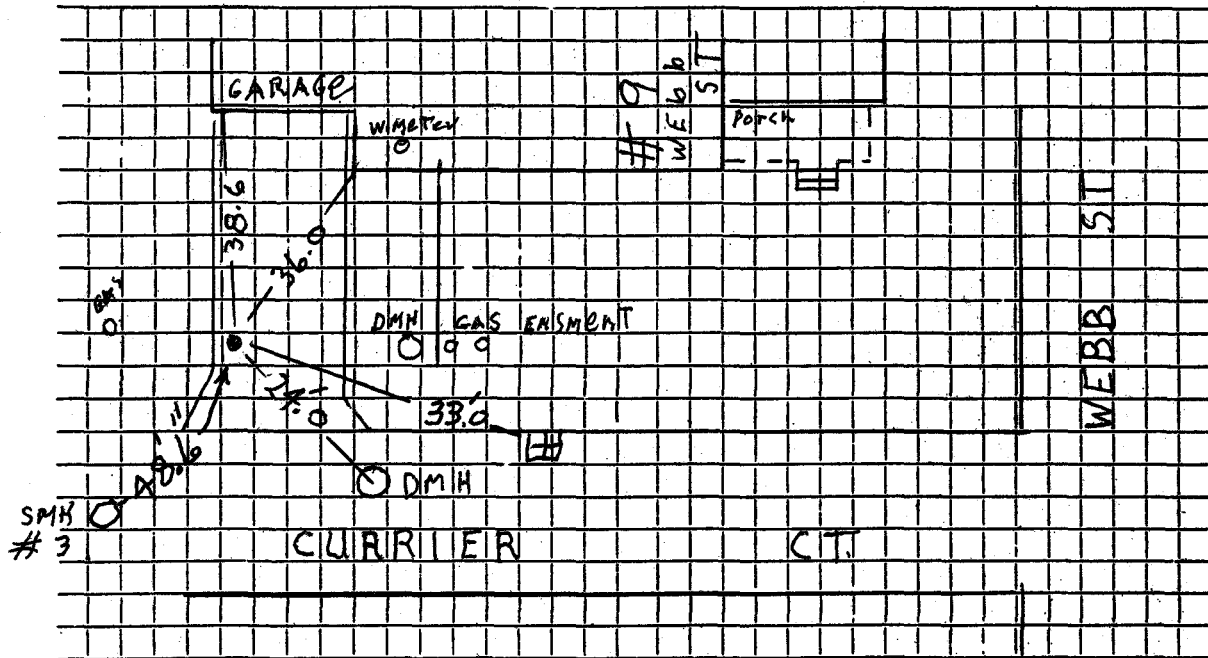

Connection made in Currier Ct. Street.

Work completed J. McLaughlin

Remarks: original house 11/2/60 T. Dwn