




DATE \_\_\_\_\_

TOWN OF LEXINGTON — BOARD OF PUBLIC WORKS  
WATER DIVISION

Sketch of Service Here

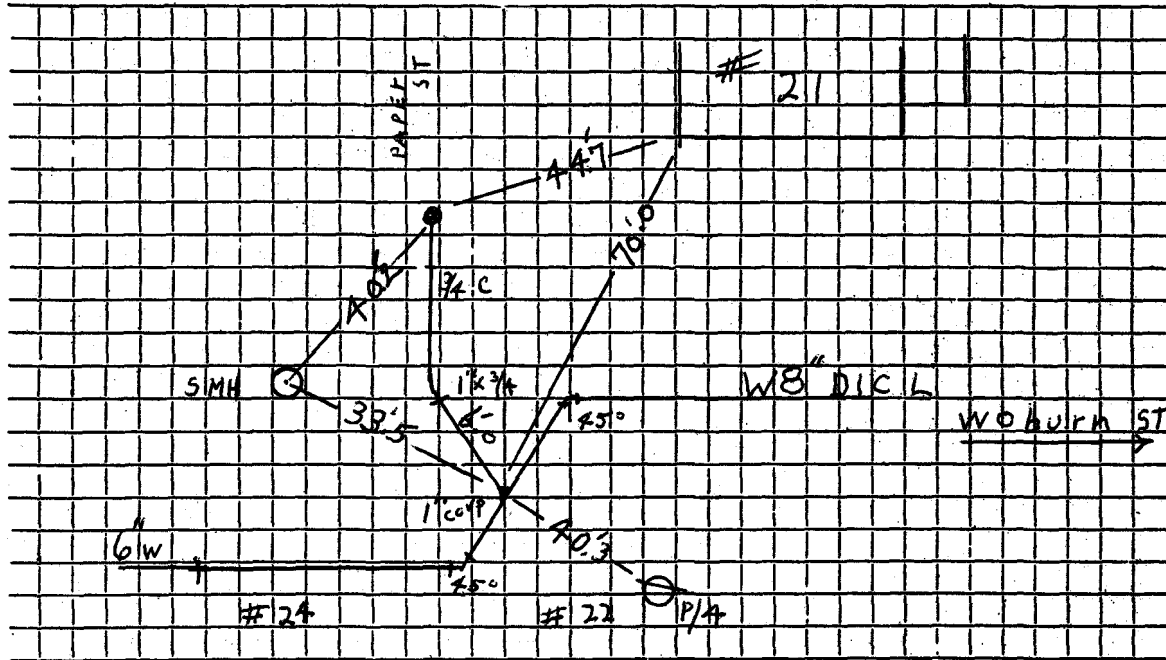

Connection made in Webb ST..... Street. Work completed 2007 Def. 1. c.....

Remarks: Ex. J. Dunham ST.....

.....

.....