

WATER SERVICE RECORD

13106

Name Joseph P. Restuccia

Service No. 100

Address 10 Webster Rd.

Location Lexington

~~TRANSFERRED~~ New Service

SERVICE TO CURB ONLY Comm. 10-28-57


Date	Material	Amount	Total	Date	Amount
5-27-57	labor	2 04		5-27-57	Deposit 75 00
	10% overhead	<u>20</u>		10-28-57	Refund 35 18
			2 24		NON-CHARGE \$ 39 82
	70' 3/4" copper copper tubing @.4228		29 60	3/18/53	Labor 2 92
	1 3/4" C x 1/2 IWH st & wast@		4 96	8 3/4" Copper tubing @.34	2 72
	1 hr trucking		75	1-3/4" C. Corp-cock	4 33
	1 3/4" C union 3 part		<u>2 27</u>	1-3/4" C x 3/4" C. Curb-cock	4 67
			39 82	1-Box & Rod	3 90
				1 Hr. Trucking	<u>75</u>
					19 29
				1 1/2 straight tail pc.	50
				1 1/2 offset tail piece	<u>50</u>
					20 29

DATE _____

TOWN OF LEXINGTON — BOARD OF PUBLIC WORKS

WATER DIVISION

Sketch of Service Here

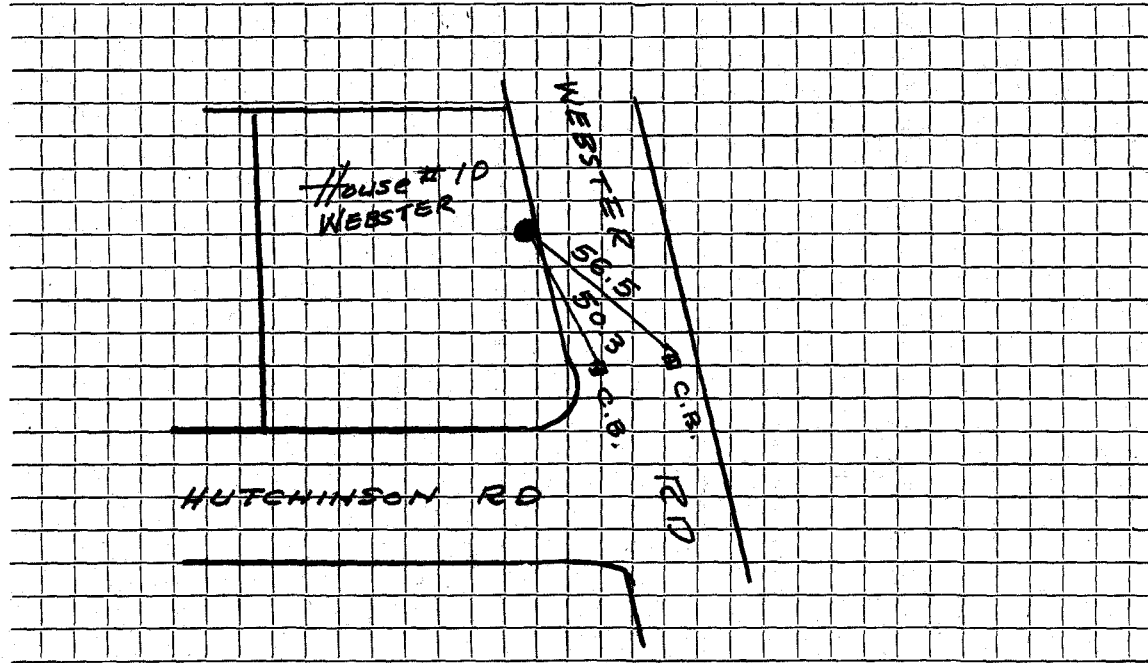

Connection made in Street. Work completed

Remarks:

.....

.....