

WATER SERVICE RECORD

2991

Name Oscar Cermier

Service No. 37

Address 11 Webster Rd.

Location Lexington

Lot L.C. 74

~~KANSAS WATER~~ New Service Farfaras #1451

SERVICE TO CURB ONLY

DEC 22 1969


Date		Material	Amount	Total	Date	Amount
9-11-69	44'	3/4" Copper tubing			8-25-69	26 77
					<i>Deposit Charge</i>	
					3/18/53	2 92
					30 3/4" Copper Tubing @.34	10 20
					1-3/4" C. Corp-cock	4 33
					1-3/4" C x 3/4" C. Curb-cock	4 67
					1-Box & Rod	3 90
					1 Hr. Trucking	75
						26 77

DATE \_\_\_\_\_

# TOWN OF LEXINGTON — BOARD OF PUBLIC WORKS

## WATER DIVISION

Sketch of Service Here

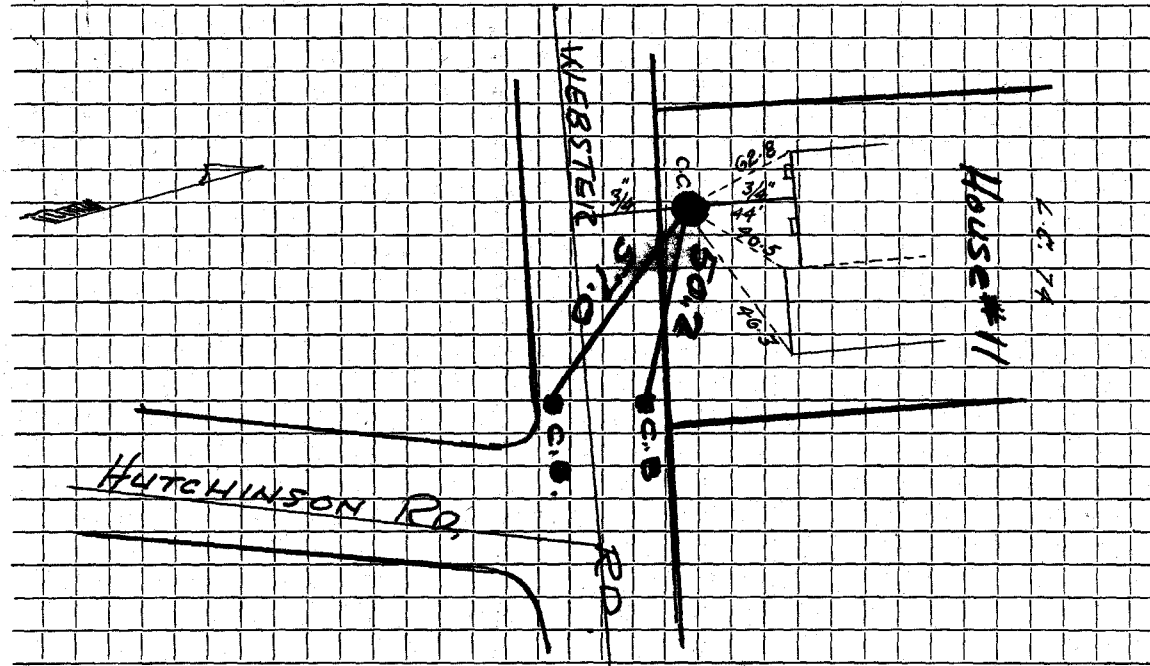

Connection made in ..... Street. Work completed .....

Remarks: .....

.....

.....