

WATER SERVICE RECORD

Name Purdy Construction Co.

Service No. 151

Address 15 Webster Rd.

Location Lexington John Devine

~~XXXXXXXXXX~~ New Service Permit #198 SERVICE TO CURB ONLY

MAY 17 1965


Date	Material	Amount	Total	Date	Amount
1-15-65	48' 3/4" Copper tubing			12-9-64	Deposit 26 76
					NON-CHARGE
				3/18/53	Labor 2 91
					30' 3/4" Copper tubing @.34 10 20
					1-3/4" C. Corp-cock 4 33
					1-3/4" C x 3/4" C. Curb-cock 4 67
					1-Box & Rod 3 90
					1 Hr. Trucking 75
					<u>26 76</u>

DATE _____

TOWN OF LEXINGTON — BOARD OF PUBLIC WORKS

WATER DIVISION

Sketch of Service Here

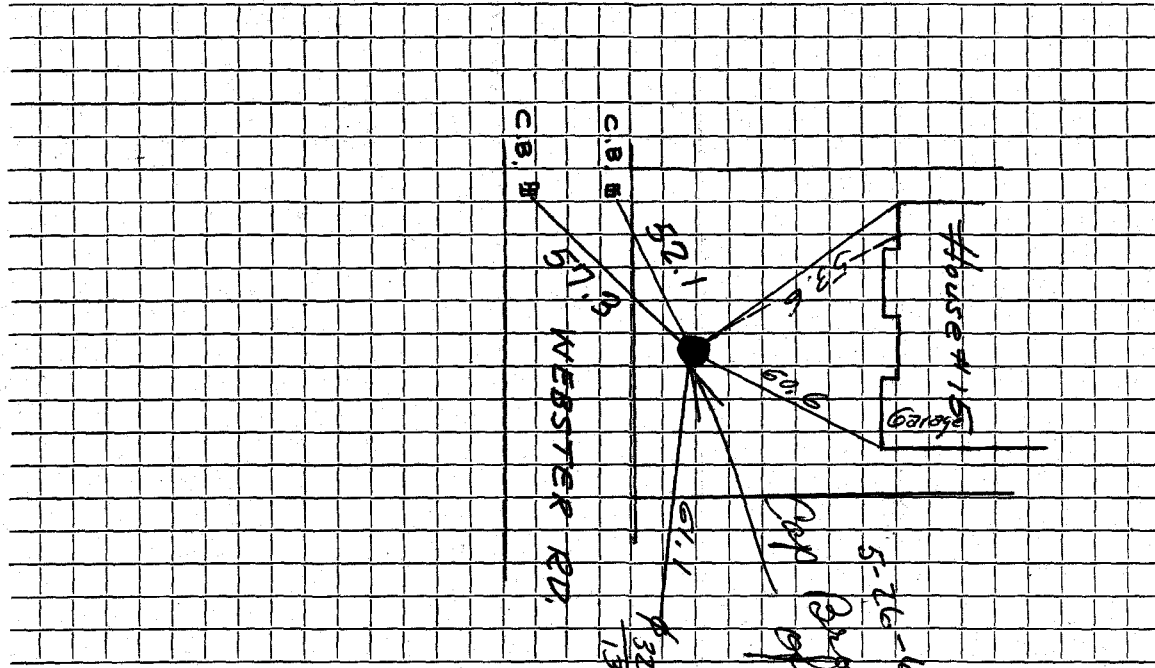

Connection made in Street. Work completed

Remarks:

.....

.....