

WATER SERVICE RECORD

Name

Service No.

Address 16 Webster Rd.

Location Lexington

~~Renewal~~ New Service


SERVICE TO CURB ONLY

Date	Material	Amount	Total	Date		Amount
8-12-55	60' 3/4" Copper					
	1 3/4" C. X 1/2" I.W.H.					
	STOP + Waste				NON-CHARGE	
				3/18/53	Labor	2 91
				8 3/4"	Copper tubing @ .34	2 72
				1-3/4"	C. Corp-cock	4 33
				1-3/4"	C x 3/4" C. Curb-cock	4 67
				1-Box	& Rod	3 90
				1 Hr.	Trucking	75
						19 28

DATE _____

TOWN OF LEXINGTON — BOARD OF PUBLIC WORKS
WATER DIVISION

Sketch of Service Here

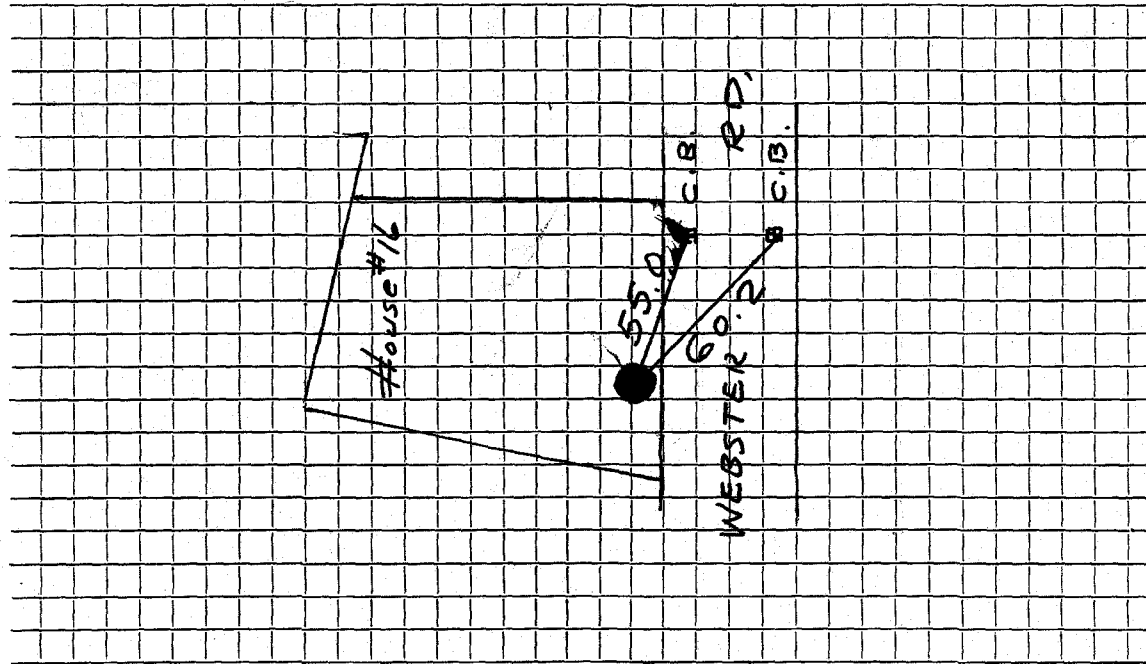

Connection made in Street. Work completed

Remarks:

.....

.....