

WATER SERVICE RECORD

Name Mrs. Andrew Belinski

Service No. 36

Address 17 Webster Rd.

Location Lexington

~~RENEWAL~~ - New Service WCH# 8678

SERVICE TO CURB ONLY

JUN 29 1964


Date	Material	Amount	Total	Date	Amount
5/8/64	Labor	2 42		5-23-64	Deposit 75 00
	10% O.H.	24	2 66	6-29-64	Retard 43 07
	55' 3/4" Copper Tubing @ .42		23 10		NON-CHARGE 31 93
	1 3/4" Cx 1/2" I.W.H. Stop & Waste		6 17		
			31 93	3/18/53	Labor 2 91
				30	3/4" Copper tubing @.34 10 20
					1-3/4" C. Corp-cock 4 33
					1-3/4" C x 3/4" C. Curb-cock 4 67
					1-Box & Red 3 90
					1 Hr. Trucking 75
					26 76
					1 1/2 Straight Tailpiece 50
					1 1/2 Offset Tailpiece 50
					27 76

DATE \_\_\_\_\_

TOWN OF LEXINGTON — BOARD OF PUBLIC WORKS

WATER DIVISION

Sketch of Service Here

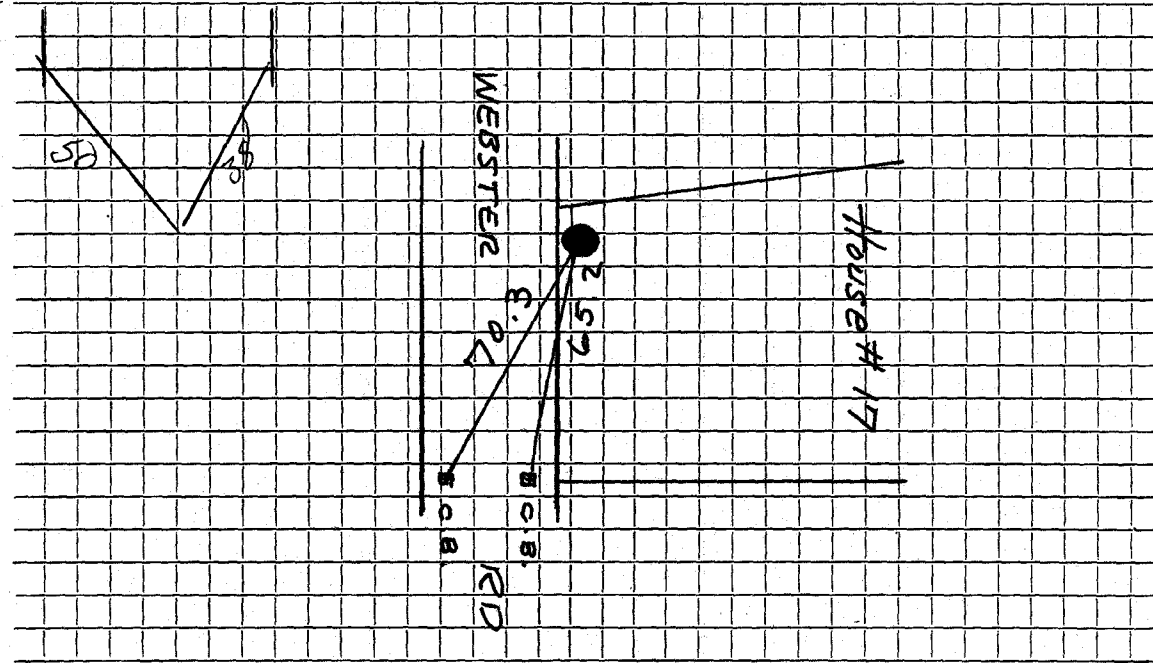

Connection made in ..... Street. Work completed .....

Remarks: .....

.....

.....