

WATER SERVICE RECORD

Name **Joseph Belotti**

Service No. **13**

Address **21 Webster Rd.**

Location **Lexington**

~~NEW SERVICE~~ New Service **W 04# 8599**

SERVICE TO CURB ONLY

JUN 29 1964


Date	Material	Amount	Total	Date	Amount
4-14-64	Labor	4 96		3-23-64	100 00
	10% O.H.	50	5 46	6-29-64	53 56
	70' 3/4" Copper tubing @.42		29 40		46 44
	1 3/4" GX 1/2 I.W.H. Stop & Waste		6 17	3/18/53 Labor	2 91
	1 3/4" C3 Part Union		2 41	30 3/4" Copper tubing @.34	10 20
	1 Hr. Trucking @3.00		3 00	1-3/4" C. Corp-cock	4 33
			46 44	1-3/4" C x 3/4" C. Curb-cock	4 67
				1-Box & Rod	3 90
				1 Hr. Trucking	75
					26 76
				4/14/64 1 1/2 Straight tailpiece	50
				1 1/2 Offset tailpiece	50
					27 76

DATE _____

TOWN OF LEXINGTON — BOARD OF PUBLIC WORKS

WATER DIVISION

Sketch of Service Here

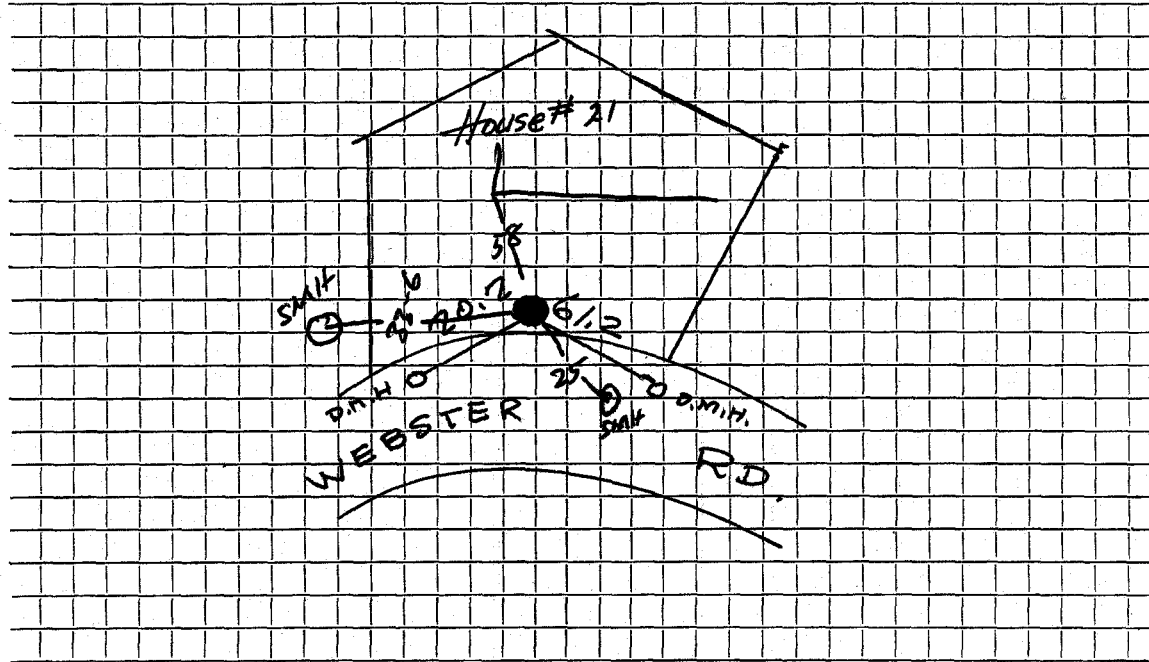

Connection made in Street. Work completed

Remarks:

.....

.....