

## WATER SERVICE RECORD

Name

Service No.

Address 22 Webster Rd.

Location Lexington

~~REPAIRS~~—New Service

SERVICE TO CURB ONLY


Date	Material	Amount	Total	Date	Amount
4-27-54	60' $\frac{3}{4}$ " Copper 1 $\frac{3}{4}$ " C. X $\frac{1}{2}$ " I.W.H. STOP + Waste				
					NON-CHARGE
				3/18/53 Labor	2 91
				8' $\frac{3}{4}$ " Copper Tubing @.34	2 72
				1- $\frac{3}{4}$ " C. Corp-cock	4 33
				1- $\frac{3}{4}$ " C x $\frac{3}{4}$ " C. Curb-cock	4 67
				1-Box & Rod	3 90
				1 Hr. Trucking	75
					<u>19 28</u>

22

DATE \_\_\_\_\_

# TOWN OF LEXINGTON - BOARD OF PUBLIC WORKS WATER DIVISION

Sketch of Service Here

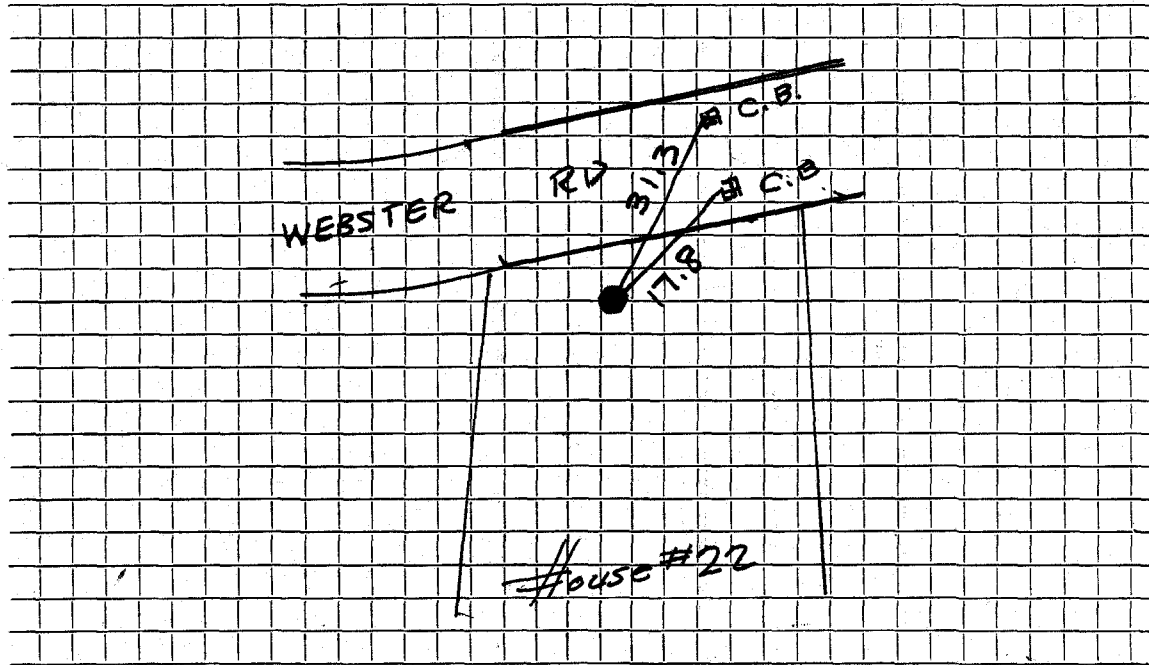

Connection made in ..... Street. Work completed .....

Remarks: .....

.....

.....