

WATER SERVICE RECORD

Name

Service No.

Address 23 Webster Rd.

Location Lexington

~~REPAIR~~ - New Service


SERVICE TO CURB ONLY

Date	Material	Amount	Total	Date	Amount
3-5-54	45' 3/4" Copper				
	1 3/4" x 1/2" l.w.h. Stop & Waste				
					NON-CHARGE
				4/15/53 Labor	4 01
				30'-3/4" Copper Tubing @.34	10 20
				1 -3/4" C. Corp-cock	4 33
				1-3/4" C x 3/4" C. Curb-cock	4 67
				1-Box & Rod	3 90
				1 Hr. Trucking	75
					<u>27 86</u>

TOWN OF LEXINGTON — BOARD OF PUBLIC WORKS

WATER DIVISION

Sketch of Service Here

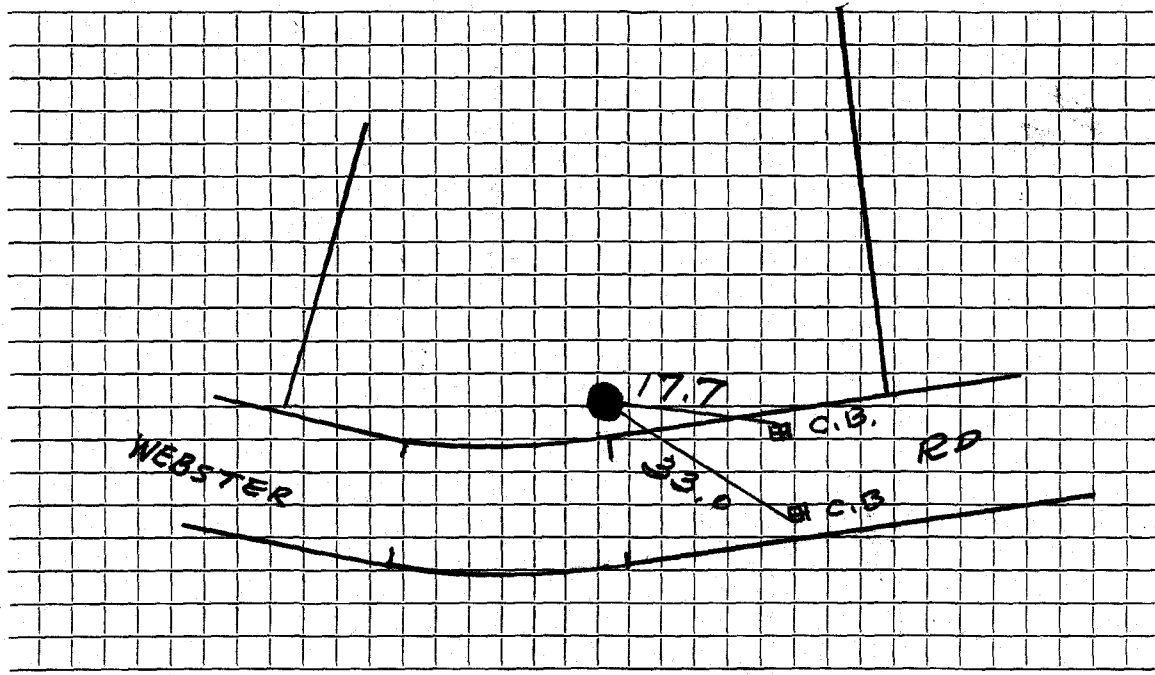

Connection made in Street. Work completed

Remarks:
.....
.....