

WATER SERVICE RECORD

Name

Service No.

Address 24 Webster Rd.

Location Lexington

~~REPLACEMENT~~ New Service


SERVICE TO CURB ONLY

Date	Material	Amount	Total	Date	Amount
4-28-54	80' 3/4" Copper				
	1 3/4" C. X 1/2" I.W.H. Stop + Waste				NON-CHARGE
	1 3/4" C. X 3/4" UNION				
				4/15/53 Labor	4 01
				8'-3/4" Copper Tubing @.34	2 72
				1-3/4" C. Corp-cock	4 33
				1-3/4" C x 3/4" C. Curb-cock	4 67
				1-Box & Rod	3 90
				1 Hr. Trucking	75 -
					20 38

TOWN OF LEXINGTON — BOARD OF PUBLIC WORKS

WATER DIVISION

Sketch of Service Here

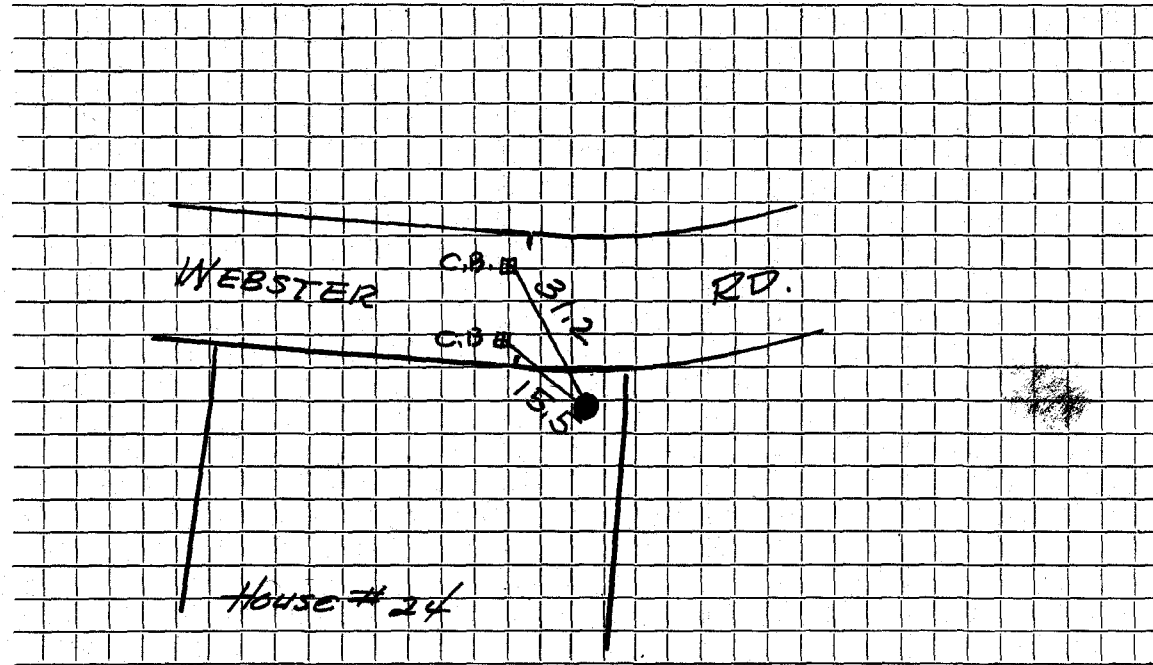

Connection made in Street. Work completed

Remarks:

.....

.....