

WATER SERVICE RECORD

Name Timothy J. Deleaney

Service No. 57

Address 26 Webster Rd.

Location Lexington

~~REPLACEMENT~~ New Service Suburbanite #A389

service to curb only OCT 3 1966


Date		Material	Amount	Total	Date		Amount
8/22/66	68'	3/4" Copper tubing			8-12-66	Deposit	70.78
					11-3-66	* Returned	50.00
						Non-CHARGE	20.38
					4/15/53	Labor	4.01
					8'-3/4"	Copper Tubing @.34	2.72
					1-3/4"	C. Corp-cock	4.33
					1-3/4"	C x 3/4" C. Curb-cock	4.67
					1-Box	& Rod	3.90
					1 Hr.	Trucking	75
							<u>20.38</u>

* Apply 11.63 to STC # 109

TOWN OF LEXINGTON — BOARD OF PUBLIC WORKS

WATER DIVISION

Sketch of Service Here

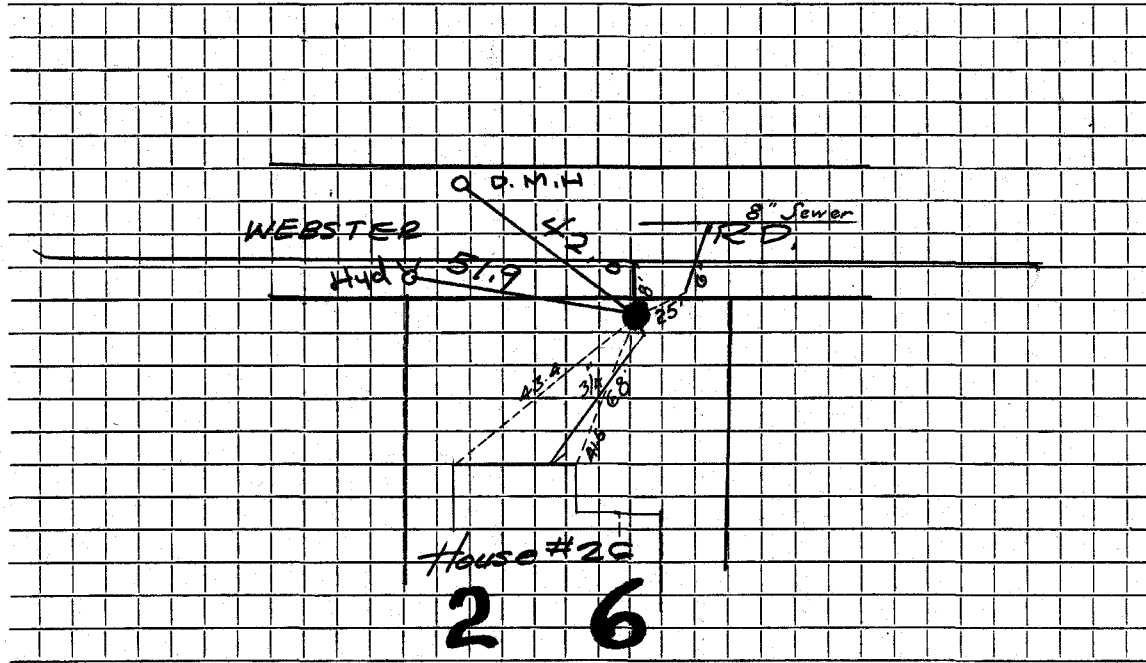

Connection made in Street. Work completed

Remarks:

.....

.....