

WATER SERVICE RECORD

Name **Edmund Tocci**

Service No. 12

Address 27 Webster Rd.

Location Lexington

~~REPAIRS~~ New Service *W044 8590*

SERVICE TO CURB ONLY


*Comm 5-18-64*

Date	Material	Amount	Total	Date	Material	Amount
3-25-64	Labor	4 73		3-17-64	Deposit	100 00
	10% O.H.	47	5 20	5-18-64	Retard	58 53
60'	3/4" Copper tubing @.42		25 20		NON-CHARGE	41 47
1	3/4" CX 1/2 I.W.H. Stop & Waste		6 17	4/15/53	Labor	4 01
1	Box & Rod		4 90	30'-3/4" Copper Tubing @.34		10 20
			41 47	1-3/4" C. Corp-cock		4 33
				1-3/4" C x 3/4" C. Curb-cock		4 67
				1-Box & Rod		3 90
				1 Hr. Trucking		75
						27 86
				3-25-64	1 1/2 Straight tailpiece	50
					1 1/2 Offset tailpiece	50
						28 86

TOWN OF LEXINGTON — BOARD OF PUBLIC WORKS

WATER DIVISION

Sketch of Service Here

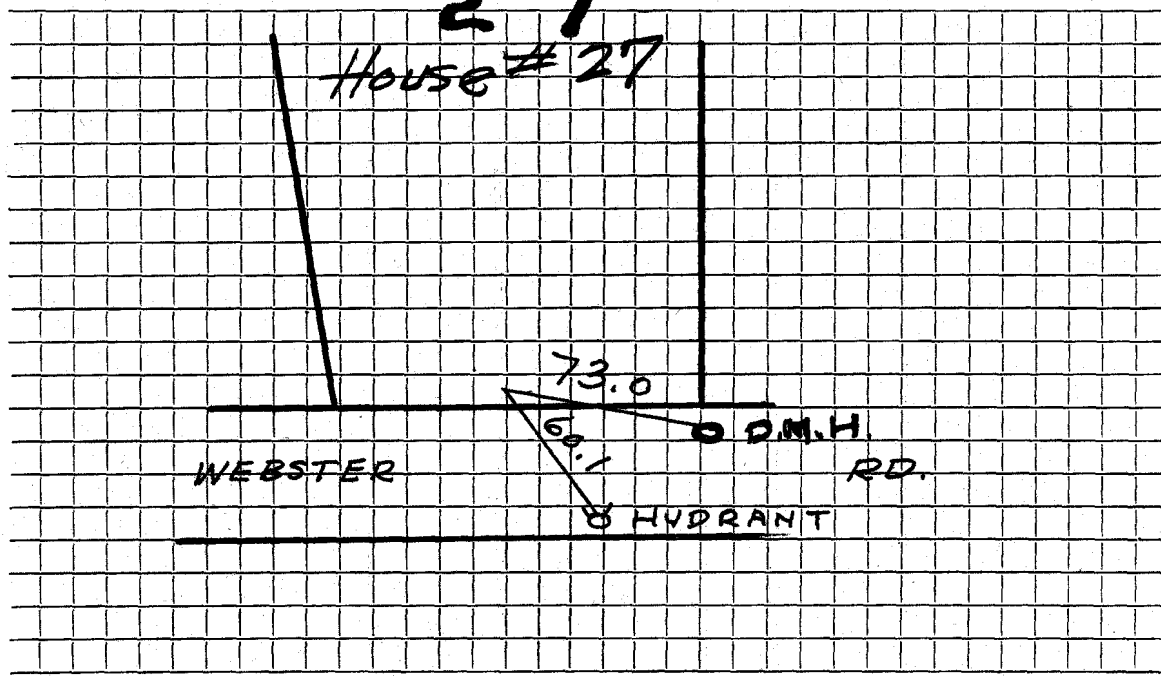

Connection made in ..... Street. Work completed .....

Remarks: .....  
.....  
.....