

WATER SERVICE RECORD

Name

Service No.

Address 28 Webster Rd.

Location Lexington

~~REPLACED~~ - New Service

service to curb only


Date	Material	Amount	Total	Date	Amount
4-4-55	75' 3/4" Copper 1 3/4" C. X 1/2" I.W.H. Stop + <del>stop</del> Waste				
	1 3/4" C. UNION				
				4/15/53 Labor	4 00
				8'-3/4" Copper Tubing @.34	2 72
				1-3/4" C. Corp-cock	4 33
				1-3/4" C x 3/4" C. Curb-cock	4 67
				1-Box & Rod	3 90
				1 Hr. Trucking	75
					<u>20 37</u>

NON-CHARGE

TOWN OF LEXINGTON - BOARD OF PUBLIC WORKS

WATER DIVISION

Sketch of Service Here

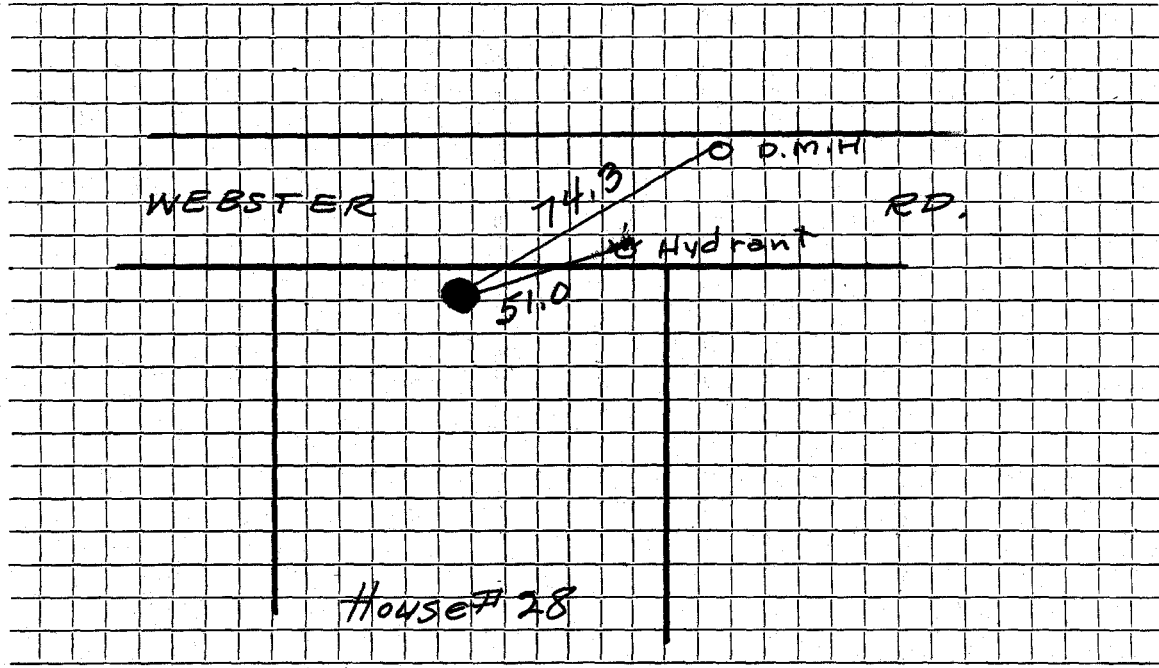

Connection made in ..... Street. Work completed .....

Remarks: .....  
.....  
.....