

WATER SERVICE RECORD

Name

Service No.

Address

Webster ^{House # 3} Road (lot 20)

Location

3 Webster Rd.

~~Repair - Renewal~~ - New Service


SERVICE TO CURB

Date	Material	Amount	Total	Date	Amount
12-17-53	55' 3/4" Copper				
	1 3/4" C. X 1/2" I.W.H. Stop + Waste				
				<u>NON CHARGE</u>	
				Labor 10/9/52	3 74
				27' - 3/4" Copper tubing @ .34	9 18
				1 - 3/4" C. corp-cock	4 33
				1 - 3/4" C x 3/4" C. curb-cock	4 67
				1 box and rod	3 90
				1 hr. trucking	75
					<u>26 57</u>

DATE _____

TOWN OF LEXINGTON — BOARD OF PUBLIC WORKS

WATER DIVISION

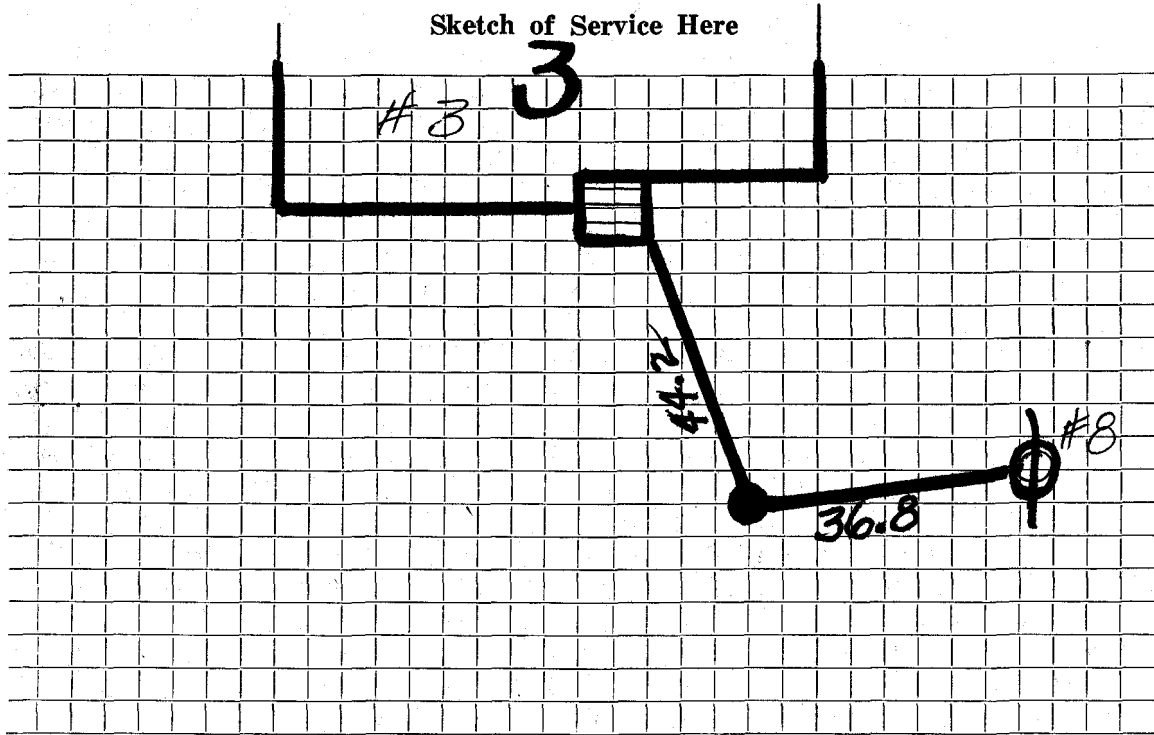

Connection made in Street. Work completed

Remarks:
.....
.....