

WATER SERVICE RECORD

Name

Service No.

Address 31 Webster Rd.

Location Lexington

~~Repair~~ - New Service

SERVICE TO CURB ONLY


Date	Material	Amount	Total	Date	Amount
6-5-54	55' 3/4" Copper 1 3/4" C. X 1/2" I.W.H. Stop + Waste				
					NON-CHARGE
				4/16/53 Labor	6 72
				30' - 3/4" Copper Tubing @ .34	10 20
				1-3/4" C. Corp-cock	4 33
				1-3/4" C x 3/4" C. Curb-cock	4 67
				1-Box & Rod	3 90
				1 Hr. Trucking	75
					<u>30 57</u>

DATE _____

TOWN OF LEXINGTON — BOARD OF PUBLIC WORKS

WATER DIVISION

Sketch of Service Here

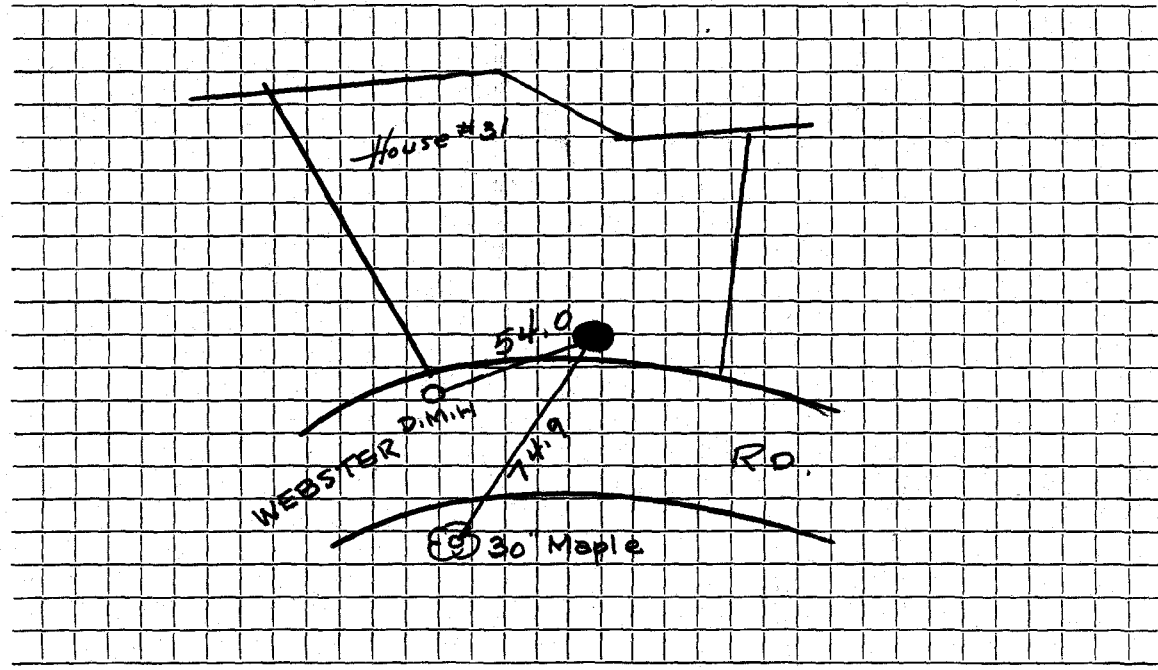

Connection made in Street. Work completed

Remarks:

.....

.....