


Date: Sep, 2022

TOWN OF LEXINGTON - BOARD OF PUBLIC WORKS
WATER DIVISION

SKETCH OF SERVICE HERE
33 Webster Rd

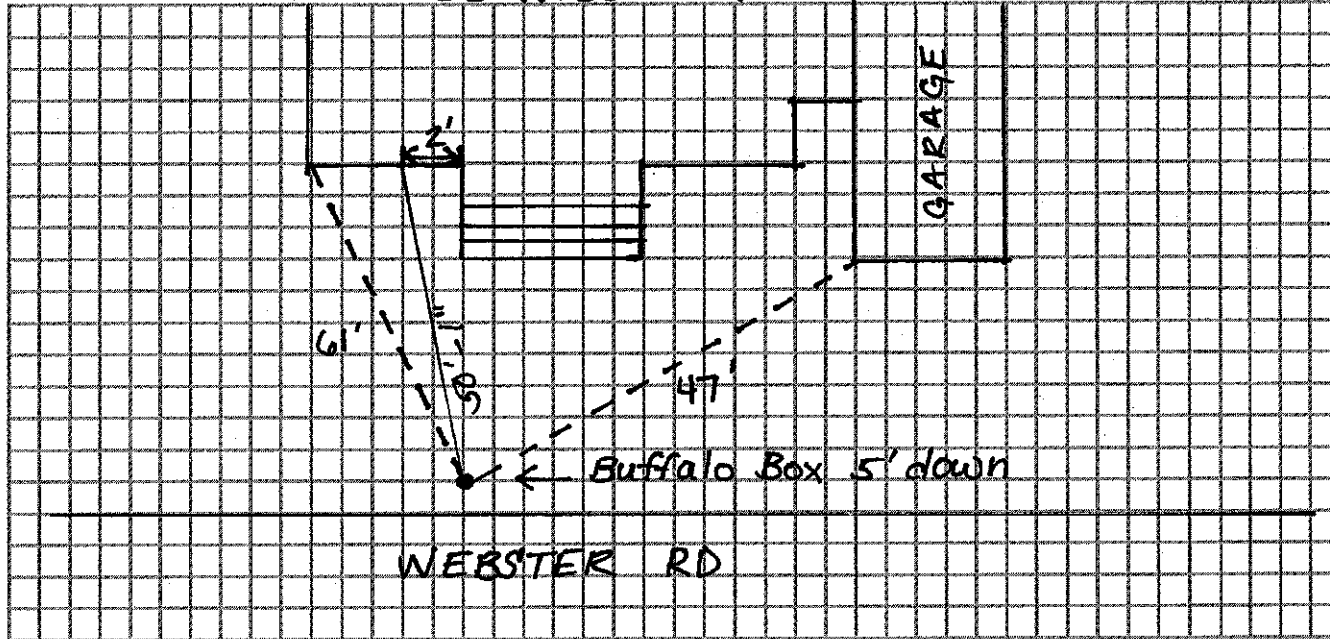

Connection made in:

Street.

Work completed:

Remarks: