

WATER SERVICE RECORD

Name

Service No.

Address 3 1/2 Webster Rd.

Location Lexington

~~Repair~~ New Service


SERVICE IN TO CURB ONLY

Date	Material	Amount	Total	Date	Amount
4-4-55	45' 3/4" Copper				
	1 3/4" C. X 1/2" l.w.h. Stop + Waste				
					NON-CHARGE
				4/17/53 Labor	3 36
				8'-3/4" Copper tubing ø.34	2 72
				1-3/4" C. Corp-cock	4 33
				1-3/4" C x 3/4" C. Curb-cock	4 67
				1-Box Rod	3 90
				1 Hr. Trucking	75
					<u>19 73</u>

TOWN OF LEXINGTON — BOARD OF PUBLIC WORKS

WATER DIVISION

Sketch of Service Here

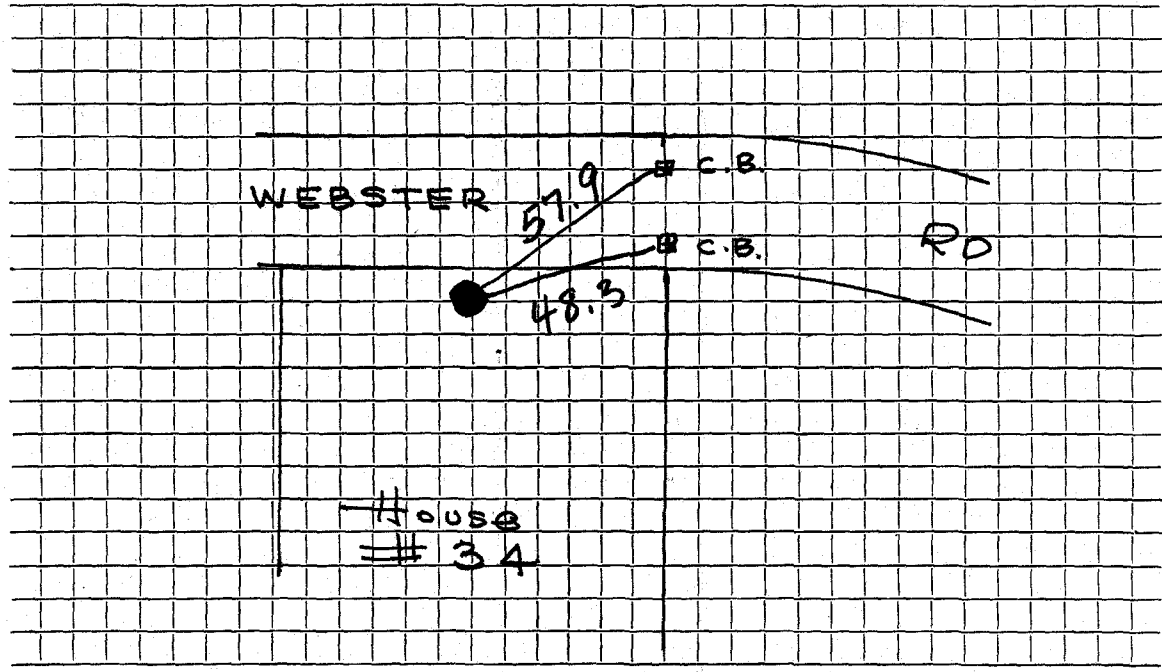

Connection made in Street. Work completed

Remarks:
.....
.....