

1353

WATER SERVICE RECORD

Name Oxford Construction Corp.

Service No. 385

Address 36 Webster Road

Location

~~Repair~~ ~~Work~~ — New Service *Com. 12-21-53*
Com. 12-21-53


Date	Material	Amount	Total	Date	Amount
12/8/53	Labor	9 50		12-7-53	Deposited Refunded NON CHARGE SERVICE WAS IN TO CURB: 1 - 1/2 straight tail piece 50 1 - 1/2 offset tail piece 50 1 00
	10% overhead	95	10 45	12-21-53	
	60' - 3/4" copper tubing @ .3629		21 77		
	1 - 3/4" C x 1/2 I.W.H. stop & waste	4 00			
	2 hrs. Littlefield shovel @ 7.50		15 00		
	1 hr. trucking		75		
			<u>51 97</u>		

DATE _____

TOWN OF LEXINGTON — BOARD OF PUBLIC WORKS

WATER DIVISION

Sketch of Service Here

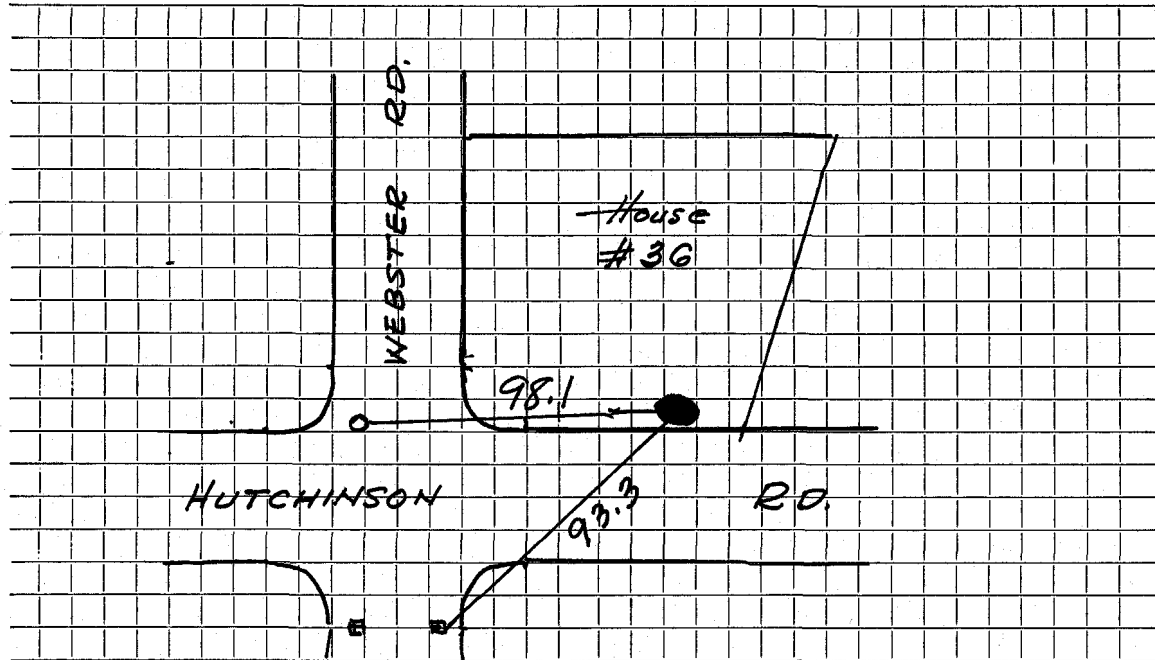


Connection made in Street. Work completed

Remarks:
.....
.....

DATE _____

TOWN OF LEXINGTON — BOARD OF PUBLIC WORKS
WATER DIVISION

Sketch of Service Here

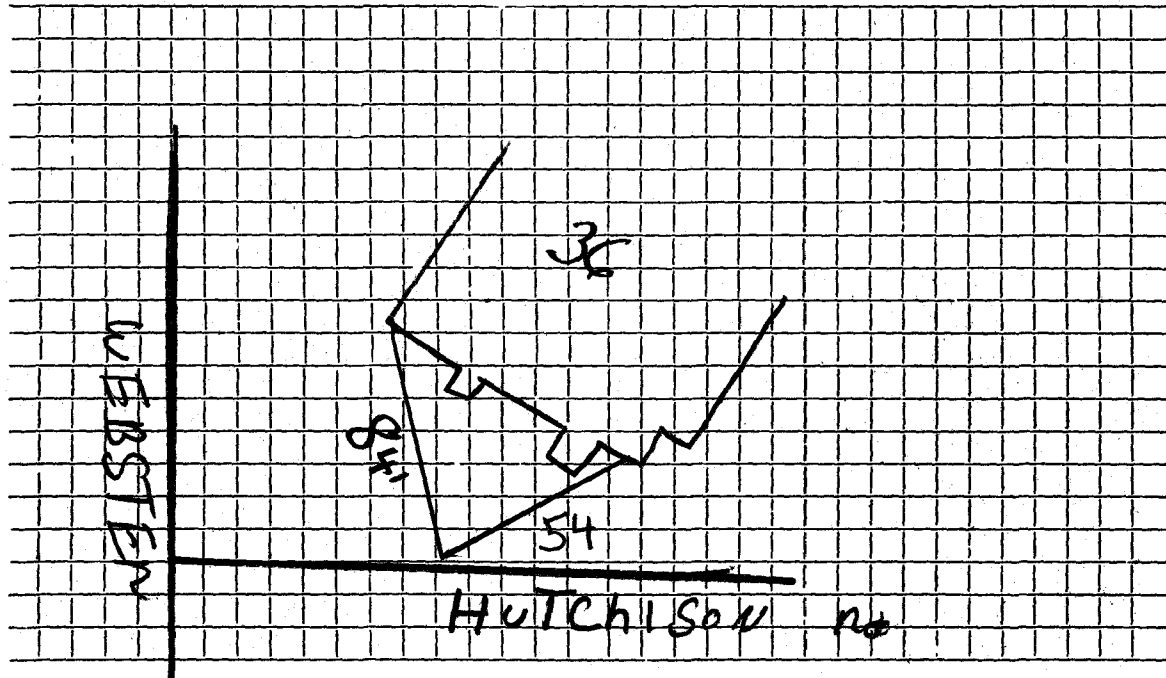

Connection made in Street. Work completed

Remarks:
.....
.....