

WATER SERVICE RECORD

Name T. E. Osborn

Service No. 92

Address 37 Webster Rd.

1704

Location Lexington

~~Water~~ ~~Service~~ - New Service

am. 7-13-53


Date	Material	Amount	Total	Date	Amount
6/11/53	Labor	3 50		5-11-53 <i>Deposited</i>	25 00
	10% overhead	35	3 85	4-6-54 <i>Paid</i>	5 67
	55'-3/4" Copper Tubing @ .37		20 35		30 67
	1-3/4" C x 1/2" I.W.H. STOP & WASTE		1 00	1-1/2 offset tail piece	50
	1-3/4" C x 3/4" C. Union (3 parts)		1 72	1-1/2 straight tail piece	50
	1 Hr. Trucking		75		1 00
			30 67		
	TRENCH DUG BY OWNER.				
				<i>bill sent 7-13-53</i>	

DATE _____

TOWN OF LEXINGTON — BOARD OF PUBLIC WORKS

WATER DIVISION

Sketch of Service Here

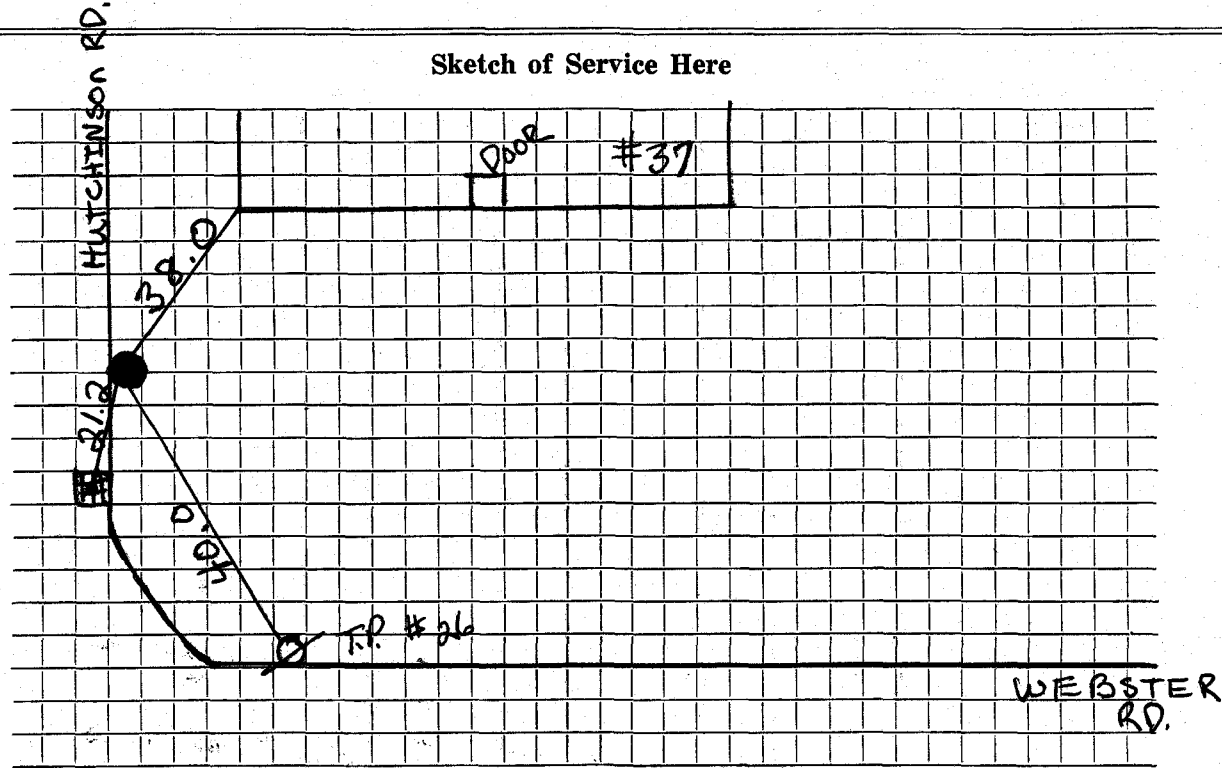

Connection made in Street. Work completed

Remarks:

.....

.....