
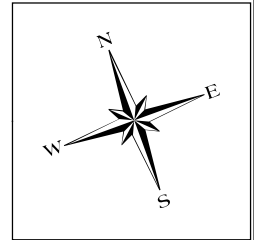


Water Service Tie Card
TOWN OF LEXINGTON
 MASSACHUSETTS

39 Webster Road

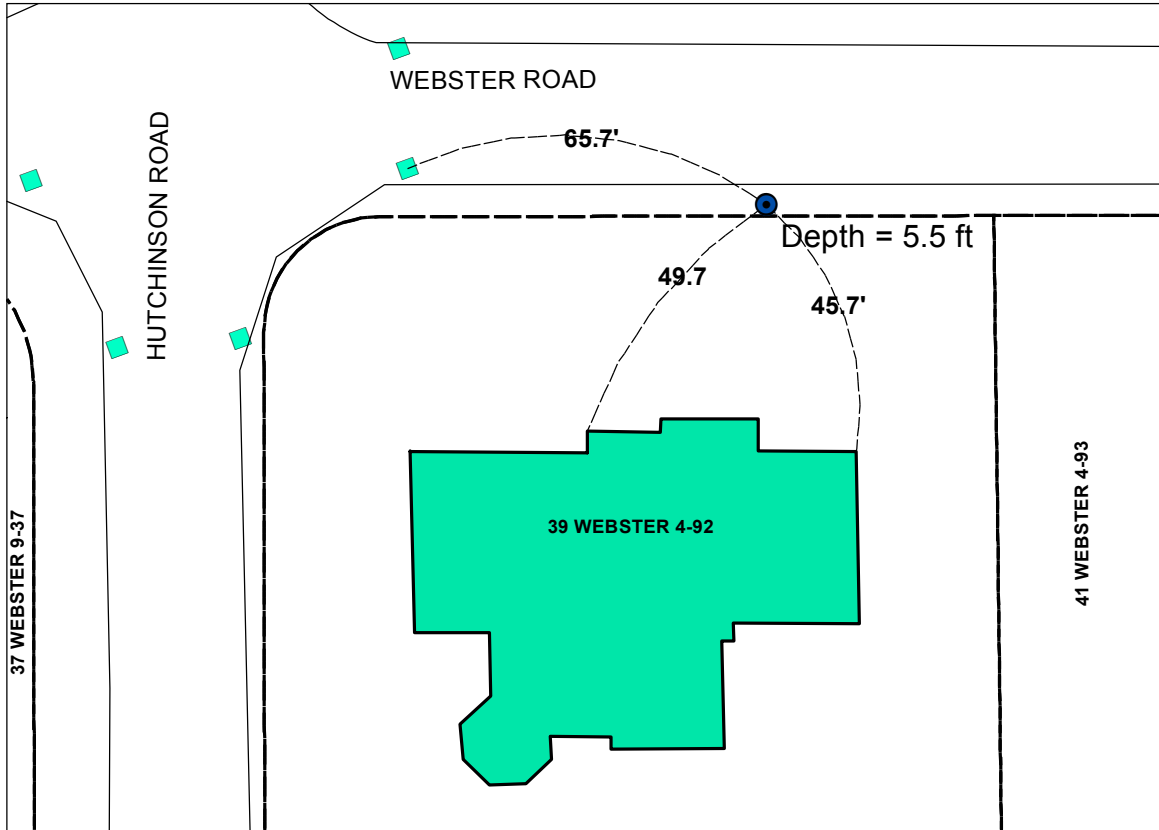

Legend	
●	Curb Stop
---	Ties_Dimensions
—	Water Service Line
---	Property Line
---	Edge of Pavement
■	CATCH BASIN

Address	Map and Lot	Permit Number	Contractor Name	Inspector
39 Webster Road	4-92	5493	Surianello, Ralph Inc.	D. Pavlik

Date: 11/25/13	Material	Amount
	3/4" Copper type "k"	3 inches
	3/4" to 1" fitting	1
	1" Copper type "k"	1 Feet
	1" Curb Valve and Buffalo Box	1
	1" Copper type "k"	65 Feet

Type of work completed

New 1" water service to house from curb stop. New house on lot old house removed.