

WATER SERVICE RECORD

Name

Service No.

Address Webster Road (lot 59)

Location 4 Webster Road

~~Repair - Renewal~~ - New Service SERVICE TO CURB


Date	Material	Amount	Total	Date	Amount
7-16-53					
	95' 3/4" Copper				NON CHARGE
	1 3/4" C. X 1/2" I.W.H. Stop + Waste			10/9/52	Labor 3 75
	1 3/4" C. X 3/4" UNION				10' - 3/4" Copper tubing @ .34 3 40
					1 - 3/4" C. corp-cock 4 33
					1 - 3/4" C x 3/4" C. curb-cock 4 67
					1 box and rod 3 90
					1 hr. trucking 75
					<u>20 80</u>

DATE _____

TOWN OF LEXINGTON — BOARD OF PUBLIC WORKS

WATER DIVISION

Sketch of Service Here

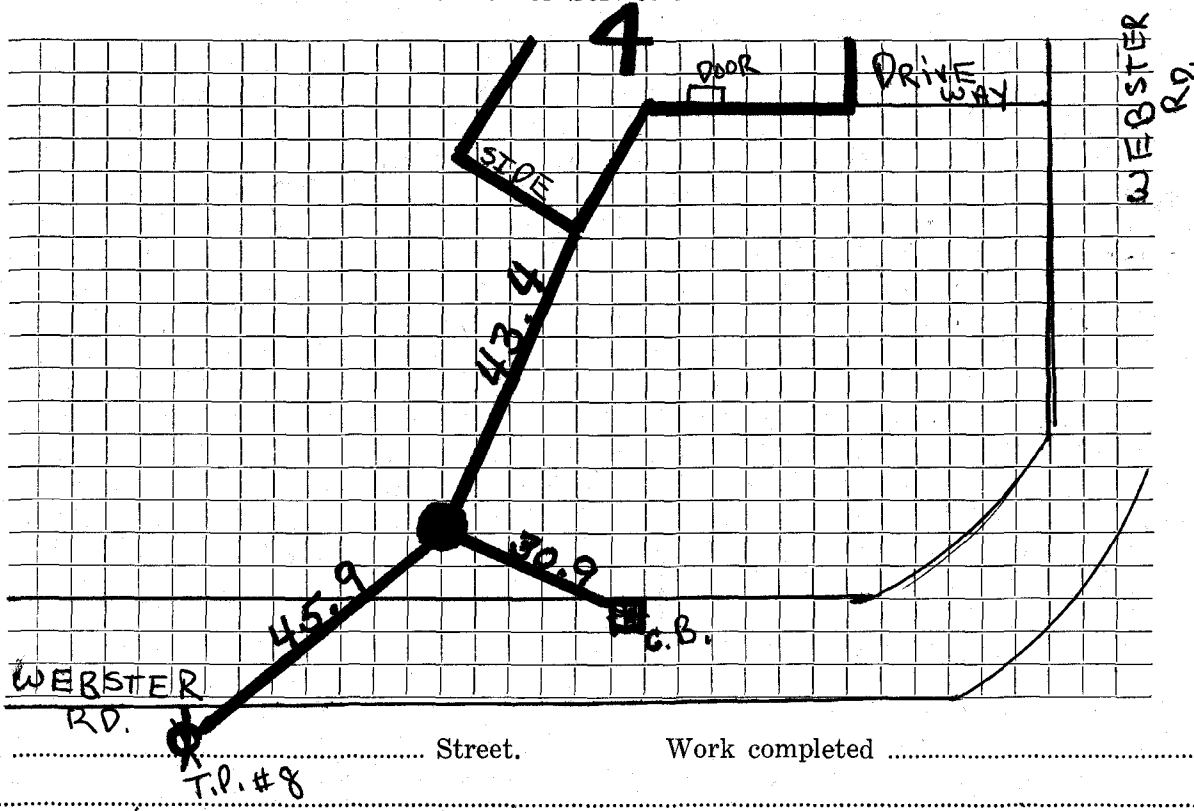

Connection made in Street. Work completed

Remarks:

.....

.....