

WATER SERVICE RECORD

Name

Service No.

Address 40 Webster Road (lot 64)

Location

~~Repair-Renewal~~ New Service SERVICE TO CURB


Date	Material	Amount	Total	Date	Amount
2-16-53	62' 3/4" Copper				
	1 3/4" C. X 1/2" I.W.H. Stop + Waste			10/4/52	6 89
	1 3/4" C. X 3/4" 3 Part Union				
					<u>NON CHARGE</u>
					Labor
					10' - 3/4" Copper tubing @ .34
					1 - 3/4" C. corp-cock
					1 - 3/4" C x 3/4" C. curb-cock
					1 box and rod
					1 hr. trucking
					3 40
					4 33
					4 67
					3 90
					75
					23 94

DATE _____

TOWN OF LEXINGTON — BOARD OF PUBLIC WORKS

WATER DIVISION

Sketch of Service Here

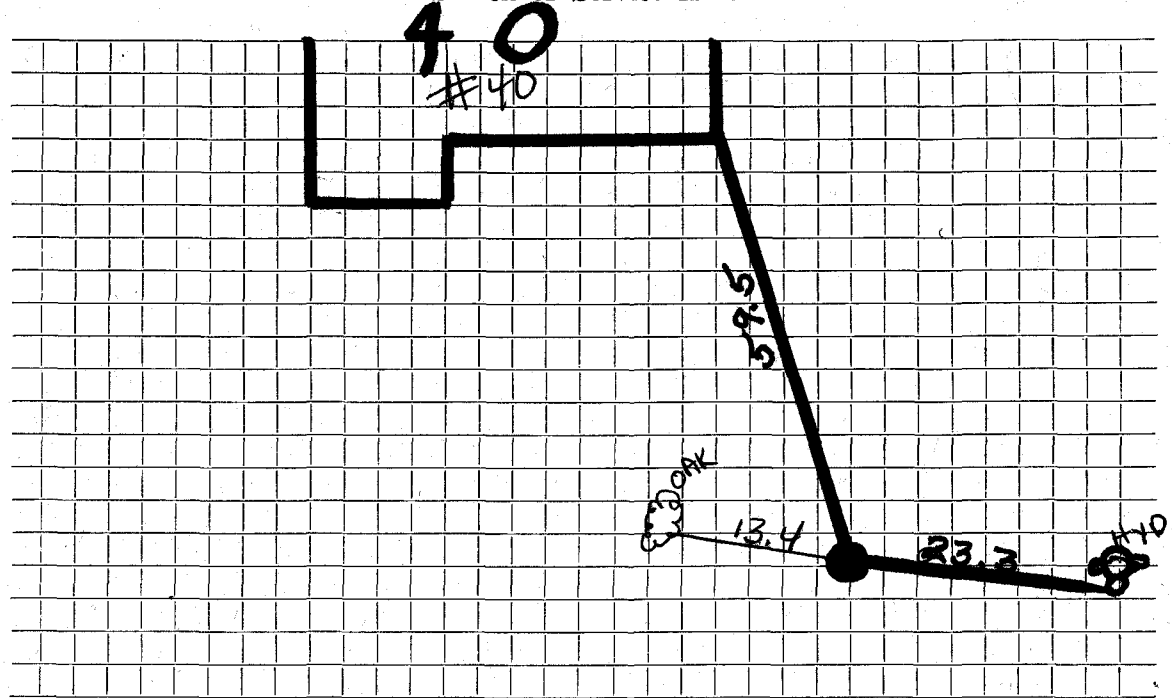

Connection made in Street. Work completed

Remarks:
.....
.....