

WATER SERVICE RECORD

Name Aldo Maselli

Service No. 99

Address 43 Webster Road (lot 85)
House # 43

Location *now lot # 82*

~~Repair - Removal~~ - New Service SERVICE TO CURB

Comm. 9/30/57


Date	Material	Amount	Total	Date	Amount
5/28/57	Labor	27 03			
	10% overhead	2 70	29 73		
	55' - 3/4" Copper tubing @ .4228		23 25		
	1 - 3/4" Cx 1/2" I.W.H. Stop & Waste		4 96		
	1 hr. Trucking		75		
	2 hrs. Town Shovel @ 6.50		13 00		
			71 69		
				5-24-57	Deposit
				7-30-57	Refused
					<u>MON CHARGE</u>
				10/4/52	Labor
					6 88
				24' - 3/4" Copper tubing @ .34	8 16
				1 - 3/4" C. corp-cock	4 33
				1 - 3/4" C x 3/4" C. curb-cock	4 67
				1 box and rod	3 90
				1 hr. trucking	75
					<u>28 69</u>
				1 - 1/8" Straight tailpiece	50
				1 - 1/8" Offset tailpiece	50
					<u>1 00</u>

DATE _____

TOWN OF LEXINGTON — BOARD OF PUBLIC WORKS

WATER DIVISION

Sketch of Service Here

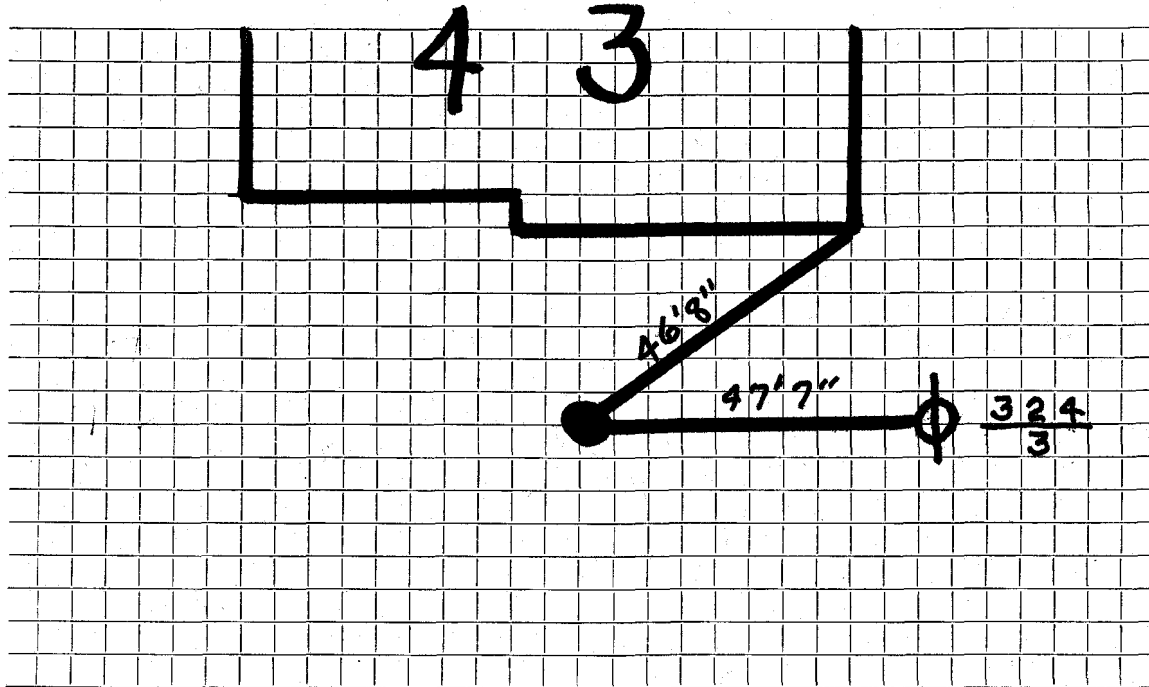

Connection made in Street. Work completed

Remarks:
.....
.....