

WATER SERVICE RECORD

Name

Service No.

Address Webster Road (lot 32)

Location **45 Webster Road**


~~Repair - Renewal~~ New Service SERVICE TO CURB

Date	Material	Amount	Total	Date	Amount
7-17-53					
	50' 3/4" Copper				NON CHARGE
	1 3/4" C. X 1/2" I.W.H. Stop + Waste			10/4/52	Labor 6 88
					24' - 3/4" Copper tubing@/34 8 16
					1 - 3/4" C. corp-cock 4 33
					1 - 3/4" C x 3/4" C. curb-cock 4 67
					1 box and rod 3 90
					1 hr. trucking 75
					28 69

DATE _____

TOWN OF LEXINGTON — BOARD OF PUBLIC WORKS
WATER DIVISION

Sketch of Service Here

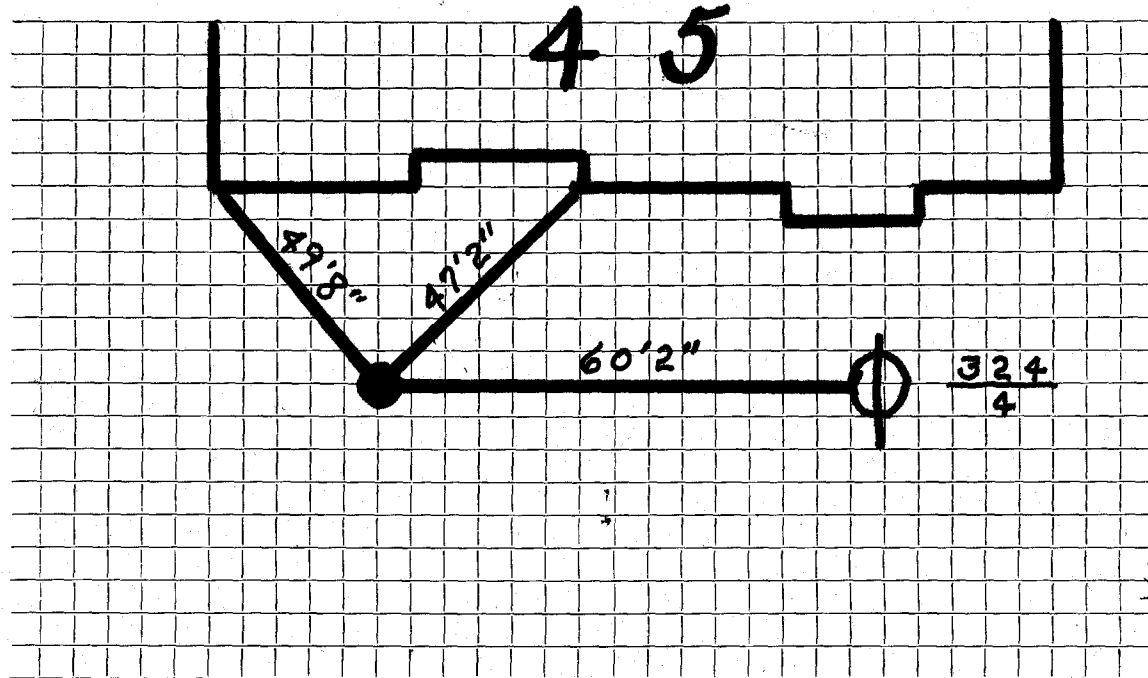

Connection made in Street. Work completed

Remarks:
.....
.....