

WATER SERVICE RECORD

Name

Service No.

Address

House # 46
Webster Road (lot 62)

Location

46 Webster Road

~~Repair/Replacement~~


New Service SERVICE TO CURB

Date	Material	Amount	Total	Date	Amount
12-28-56	60' 3/4" Copper				
	1 3/4" C. X 1/2" I.W.H. Stop + Waste				
				10/4/52	NON CHARGE
					Labor
					6 89
					12' - 3/4" Copper tubing @ .34
					4 08
					1 - 3/4" C. corp-cock
					4 33
					1 - 3/4" C x 3/4" C. curb-cock
					4 67
					1 box and rod
					3 90
					1 hr. trucking
					75
					<u>24 62</u>

DATE _____

TOWN OF LEXINGTON — BOARD OF PUBLIC WORKS
WATER DIVISION

Sketch of Service Here

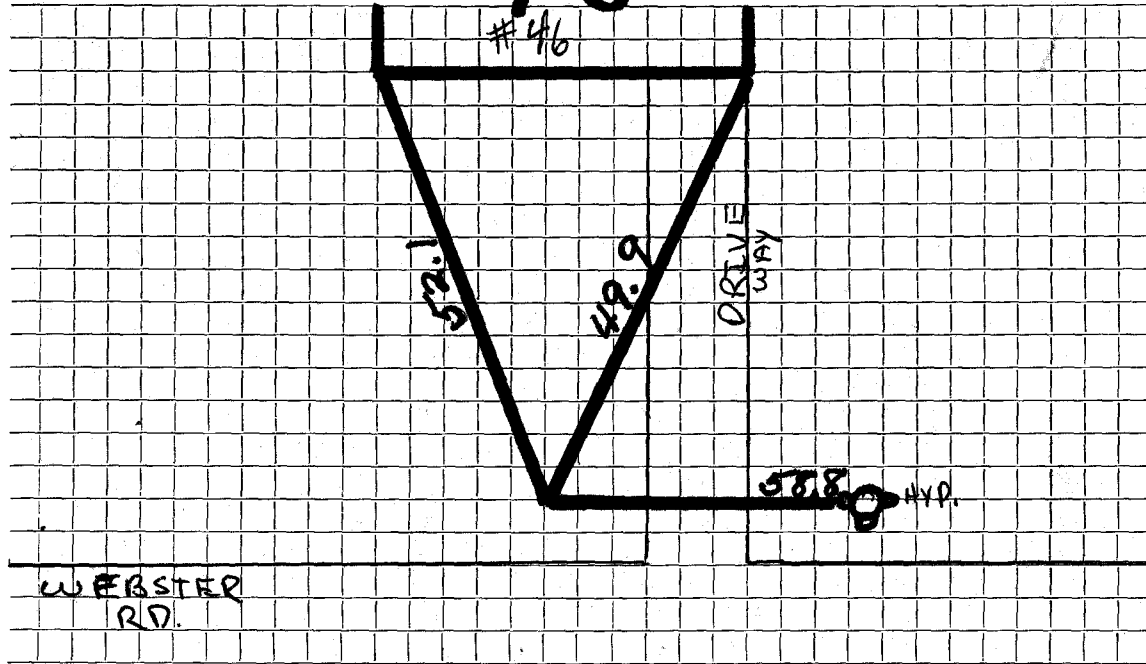

Connection made in Street. Work completed

Remarks:

.....

.....