

WATER SERVICE RECORD

Name

Service No.

Address

House # 48
Webster Road (lot 61)

Location

~~Repair/Replacement~~ — New Service


SERVICE TO CURB

Date	Material	Amount	Total	Date	Amount
12-11-53	50' 3/4" Copper				
	1 3/4" C. X 1/2" I.W.H. Stop + Waste				
				10/9/52	NON CHARGE
					Labor 3 75
					10' - 3/4" Copper tubing @ .34 3 40
					1 - 3/4" C. Corp-cock 4 33
					1 - 3/4" C x 3/4" C. curb-cock 4 67
					1 box and rod 3 90
					1 hr. trucking 75
					<u>20 80</u>

DATE _____

TOWN OF LEXINGTON — BOARD OF PUBLIC WORKS
WATER DIVISION

Sketch of Service Here

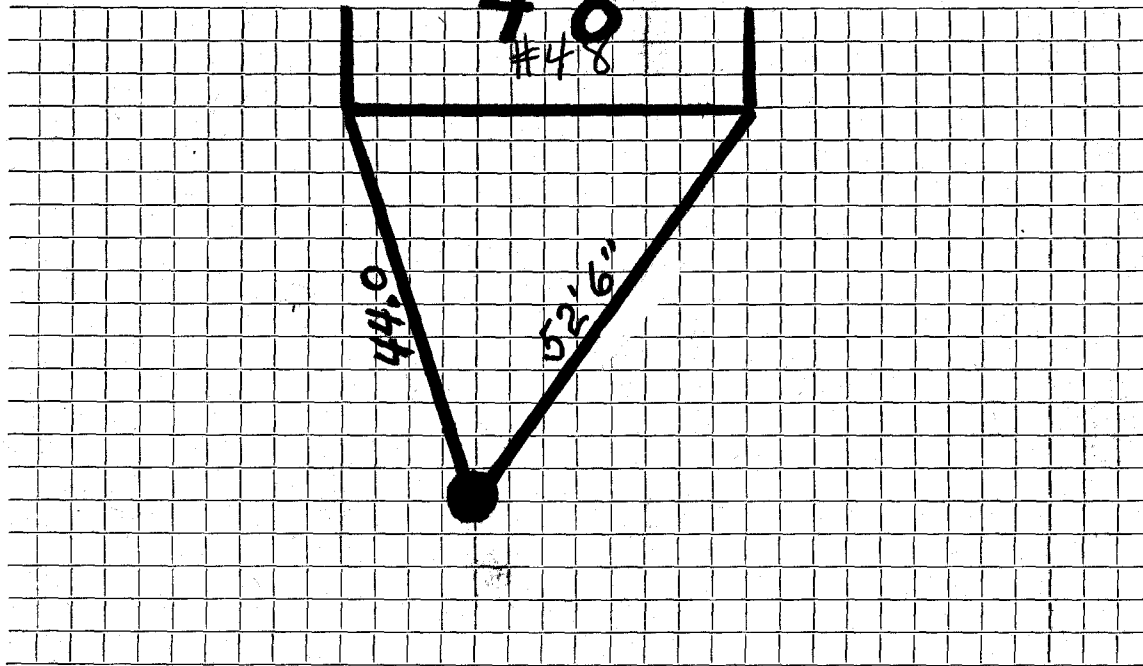

Connection made in Street. Work completed

Remarks:
.....
.....