

**WATER SERVICE RECORD**

Name

Service No.

Address

*House # 5*  
Webster Road (~~lot 28~~)

Location

*now lot 77*

~~Repair - Renewal~~ New Service

SERVICE TO CURB

Date	Material	Amount	Total	Date	Amount
					<u>NON CHARGE</u>
				10/9/52	Labor 3 74
				27' - 3/4"	Copper tubing @ .34 9 18
				1 - 3/4"	C. corp-cock 4 33
				1 - 3/4"	C x 3/4" C. curb-cock 4 67
				1 box and rod	3 90
				1 hr. trucking	75
				6-4- '62	Repair 26 57
				6' 3/4"	Copper
				1 3/4"	C. Curb Cock
				1 3/4"	C. Corp Cock
				1 3/4"	STyle 88


DATE \_\_\_\_\_

TOWN OF LEXINGTON — BOARD OF PUBLIC WORKS

**WATER DIVISION**

Sketch of Service Here

# 5

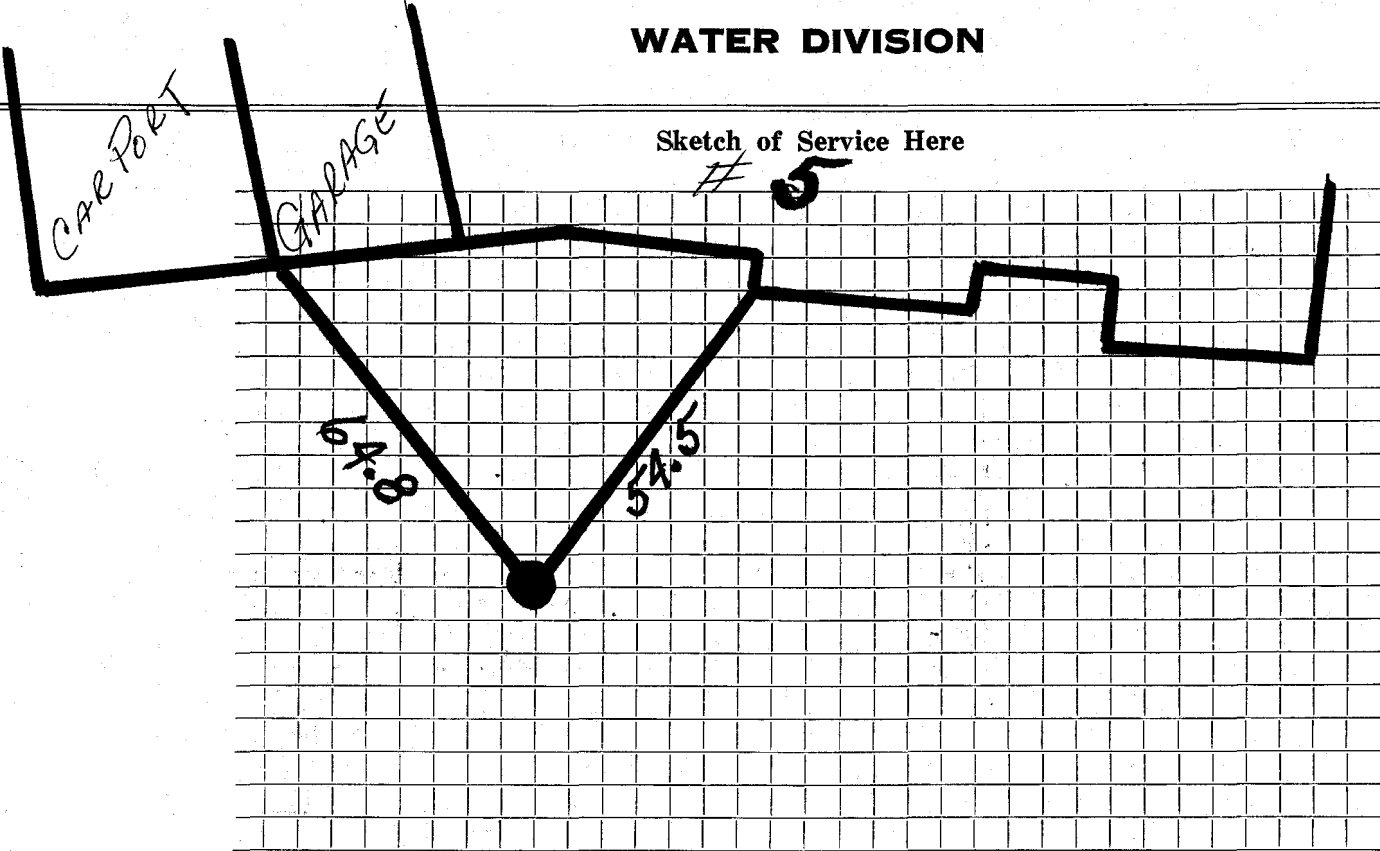

Connection made in ..... Street.

Work completed .....

Remarks: .....

.....

.....